



図面番号: 1

平成九年十二月

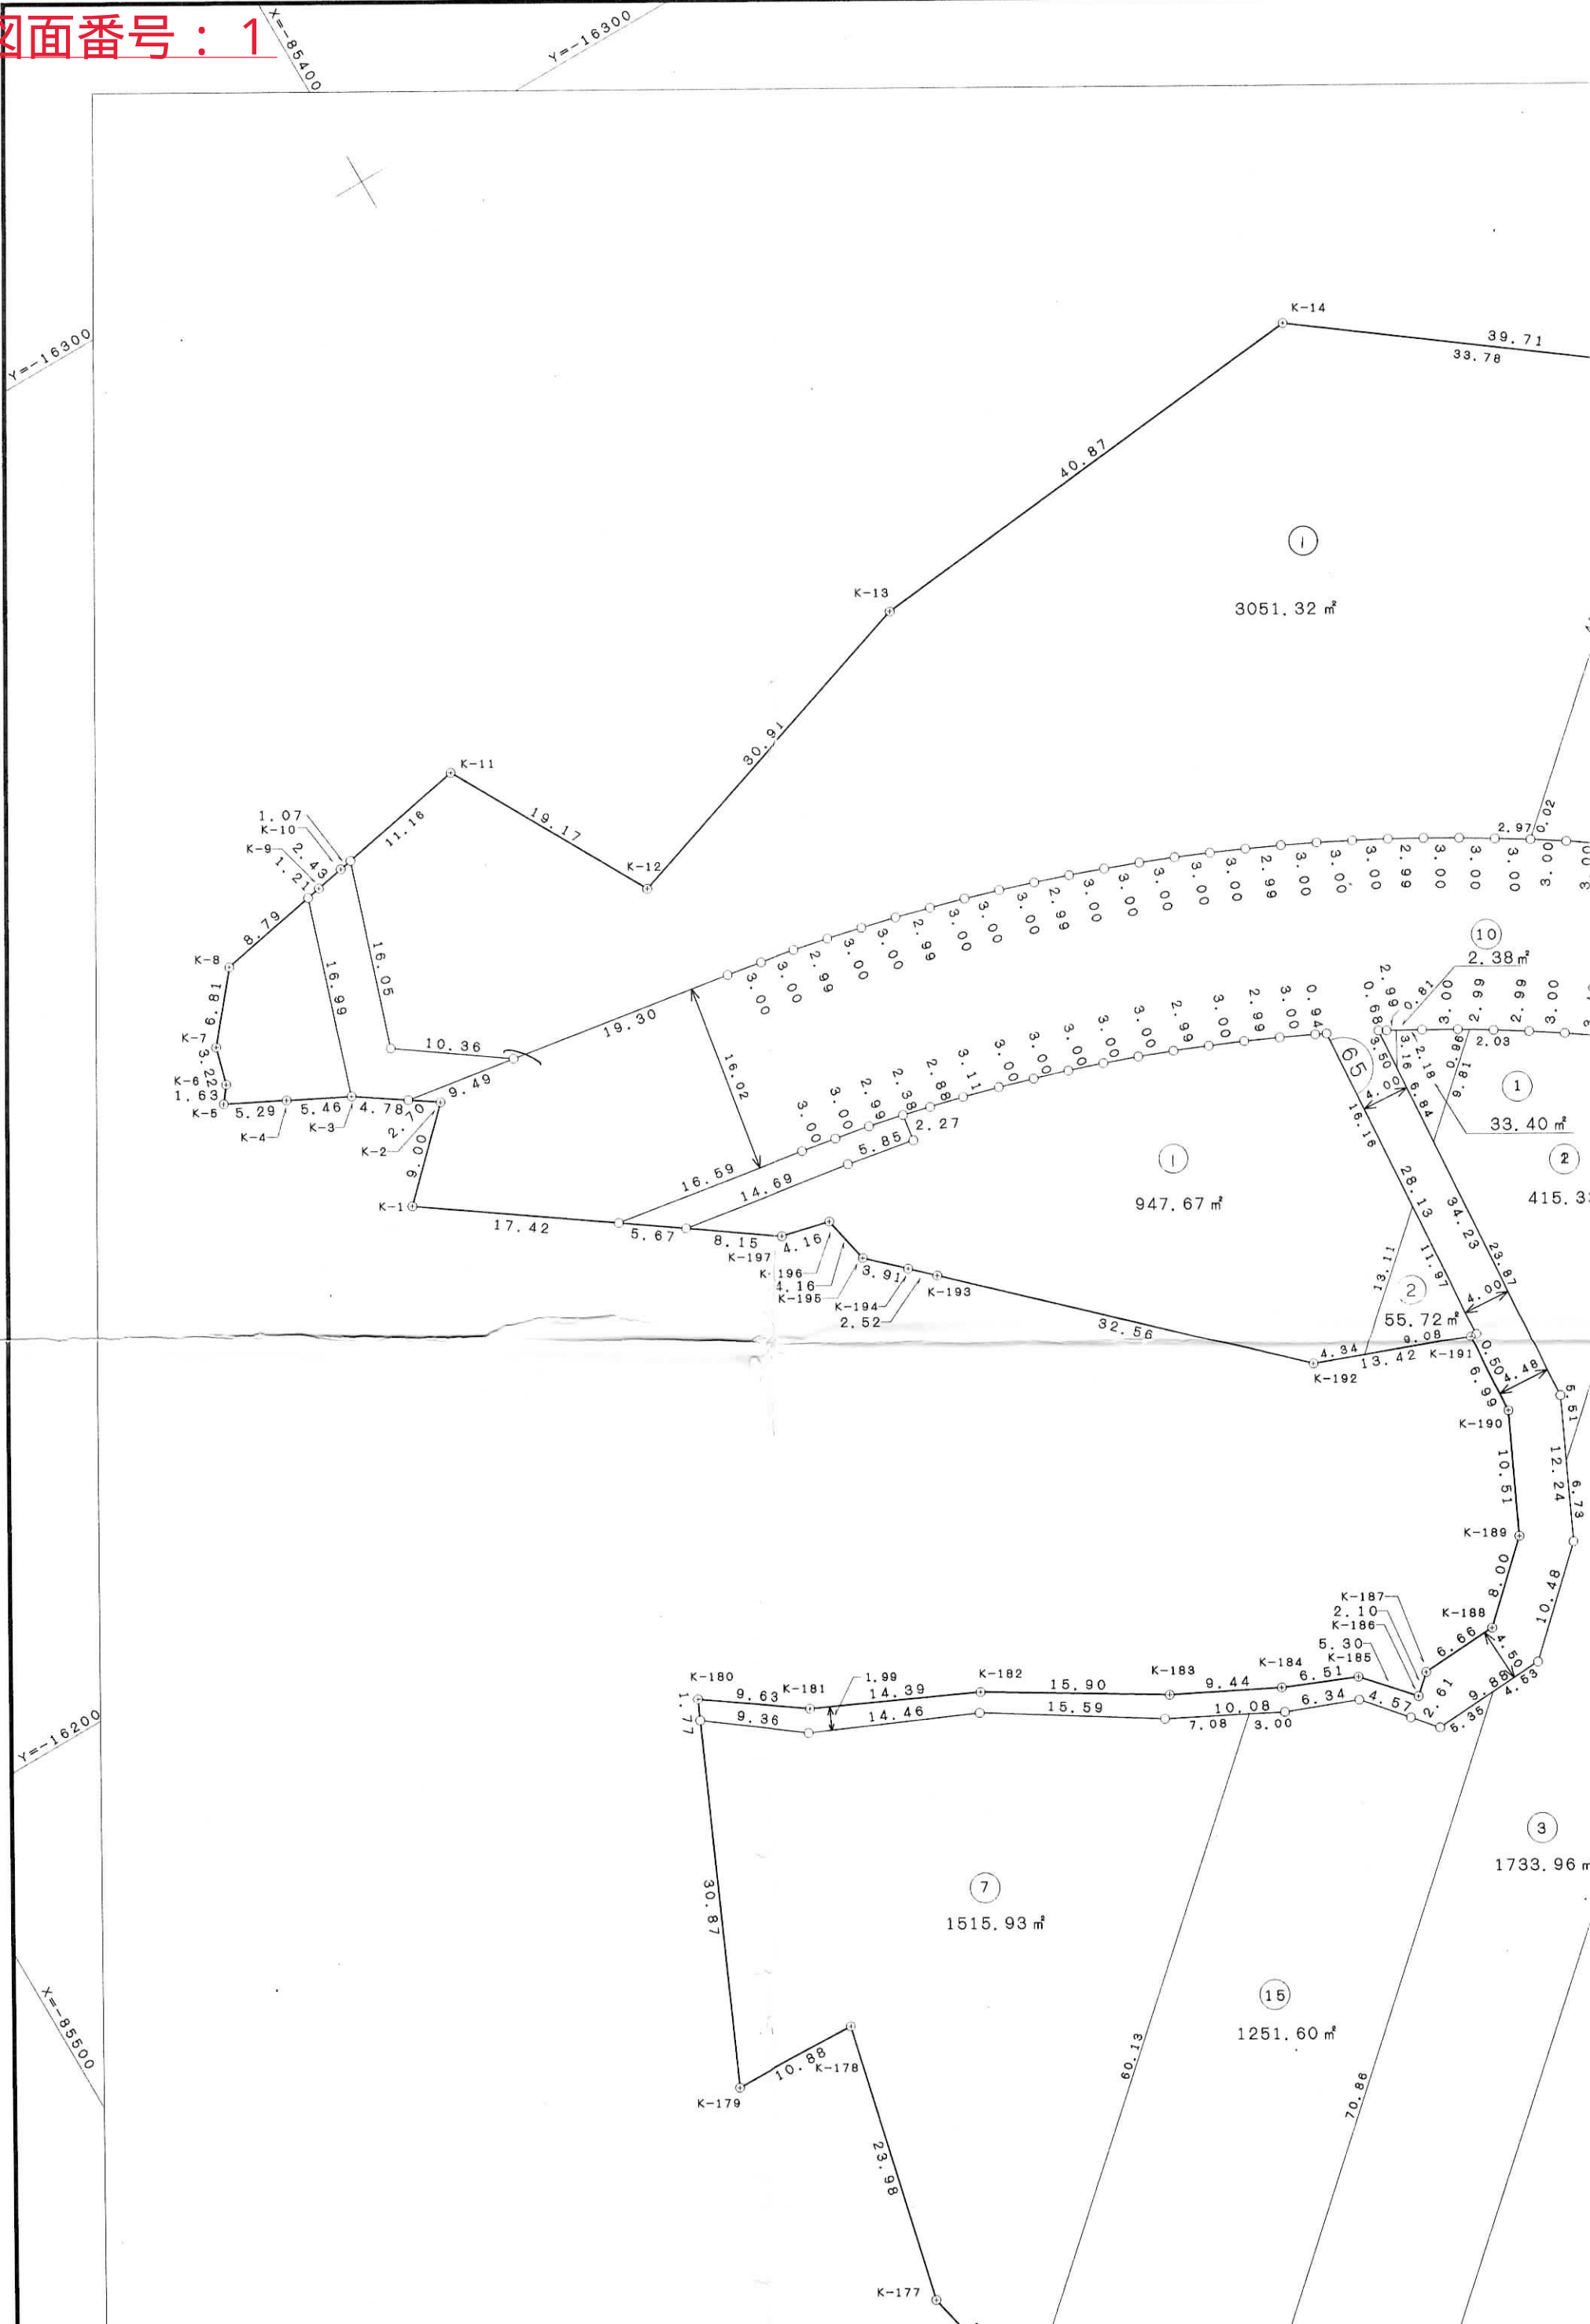


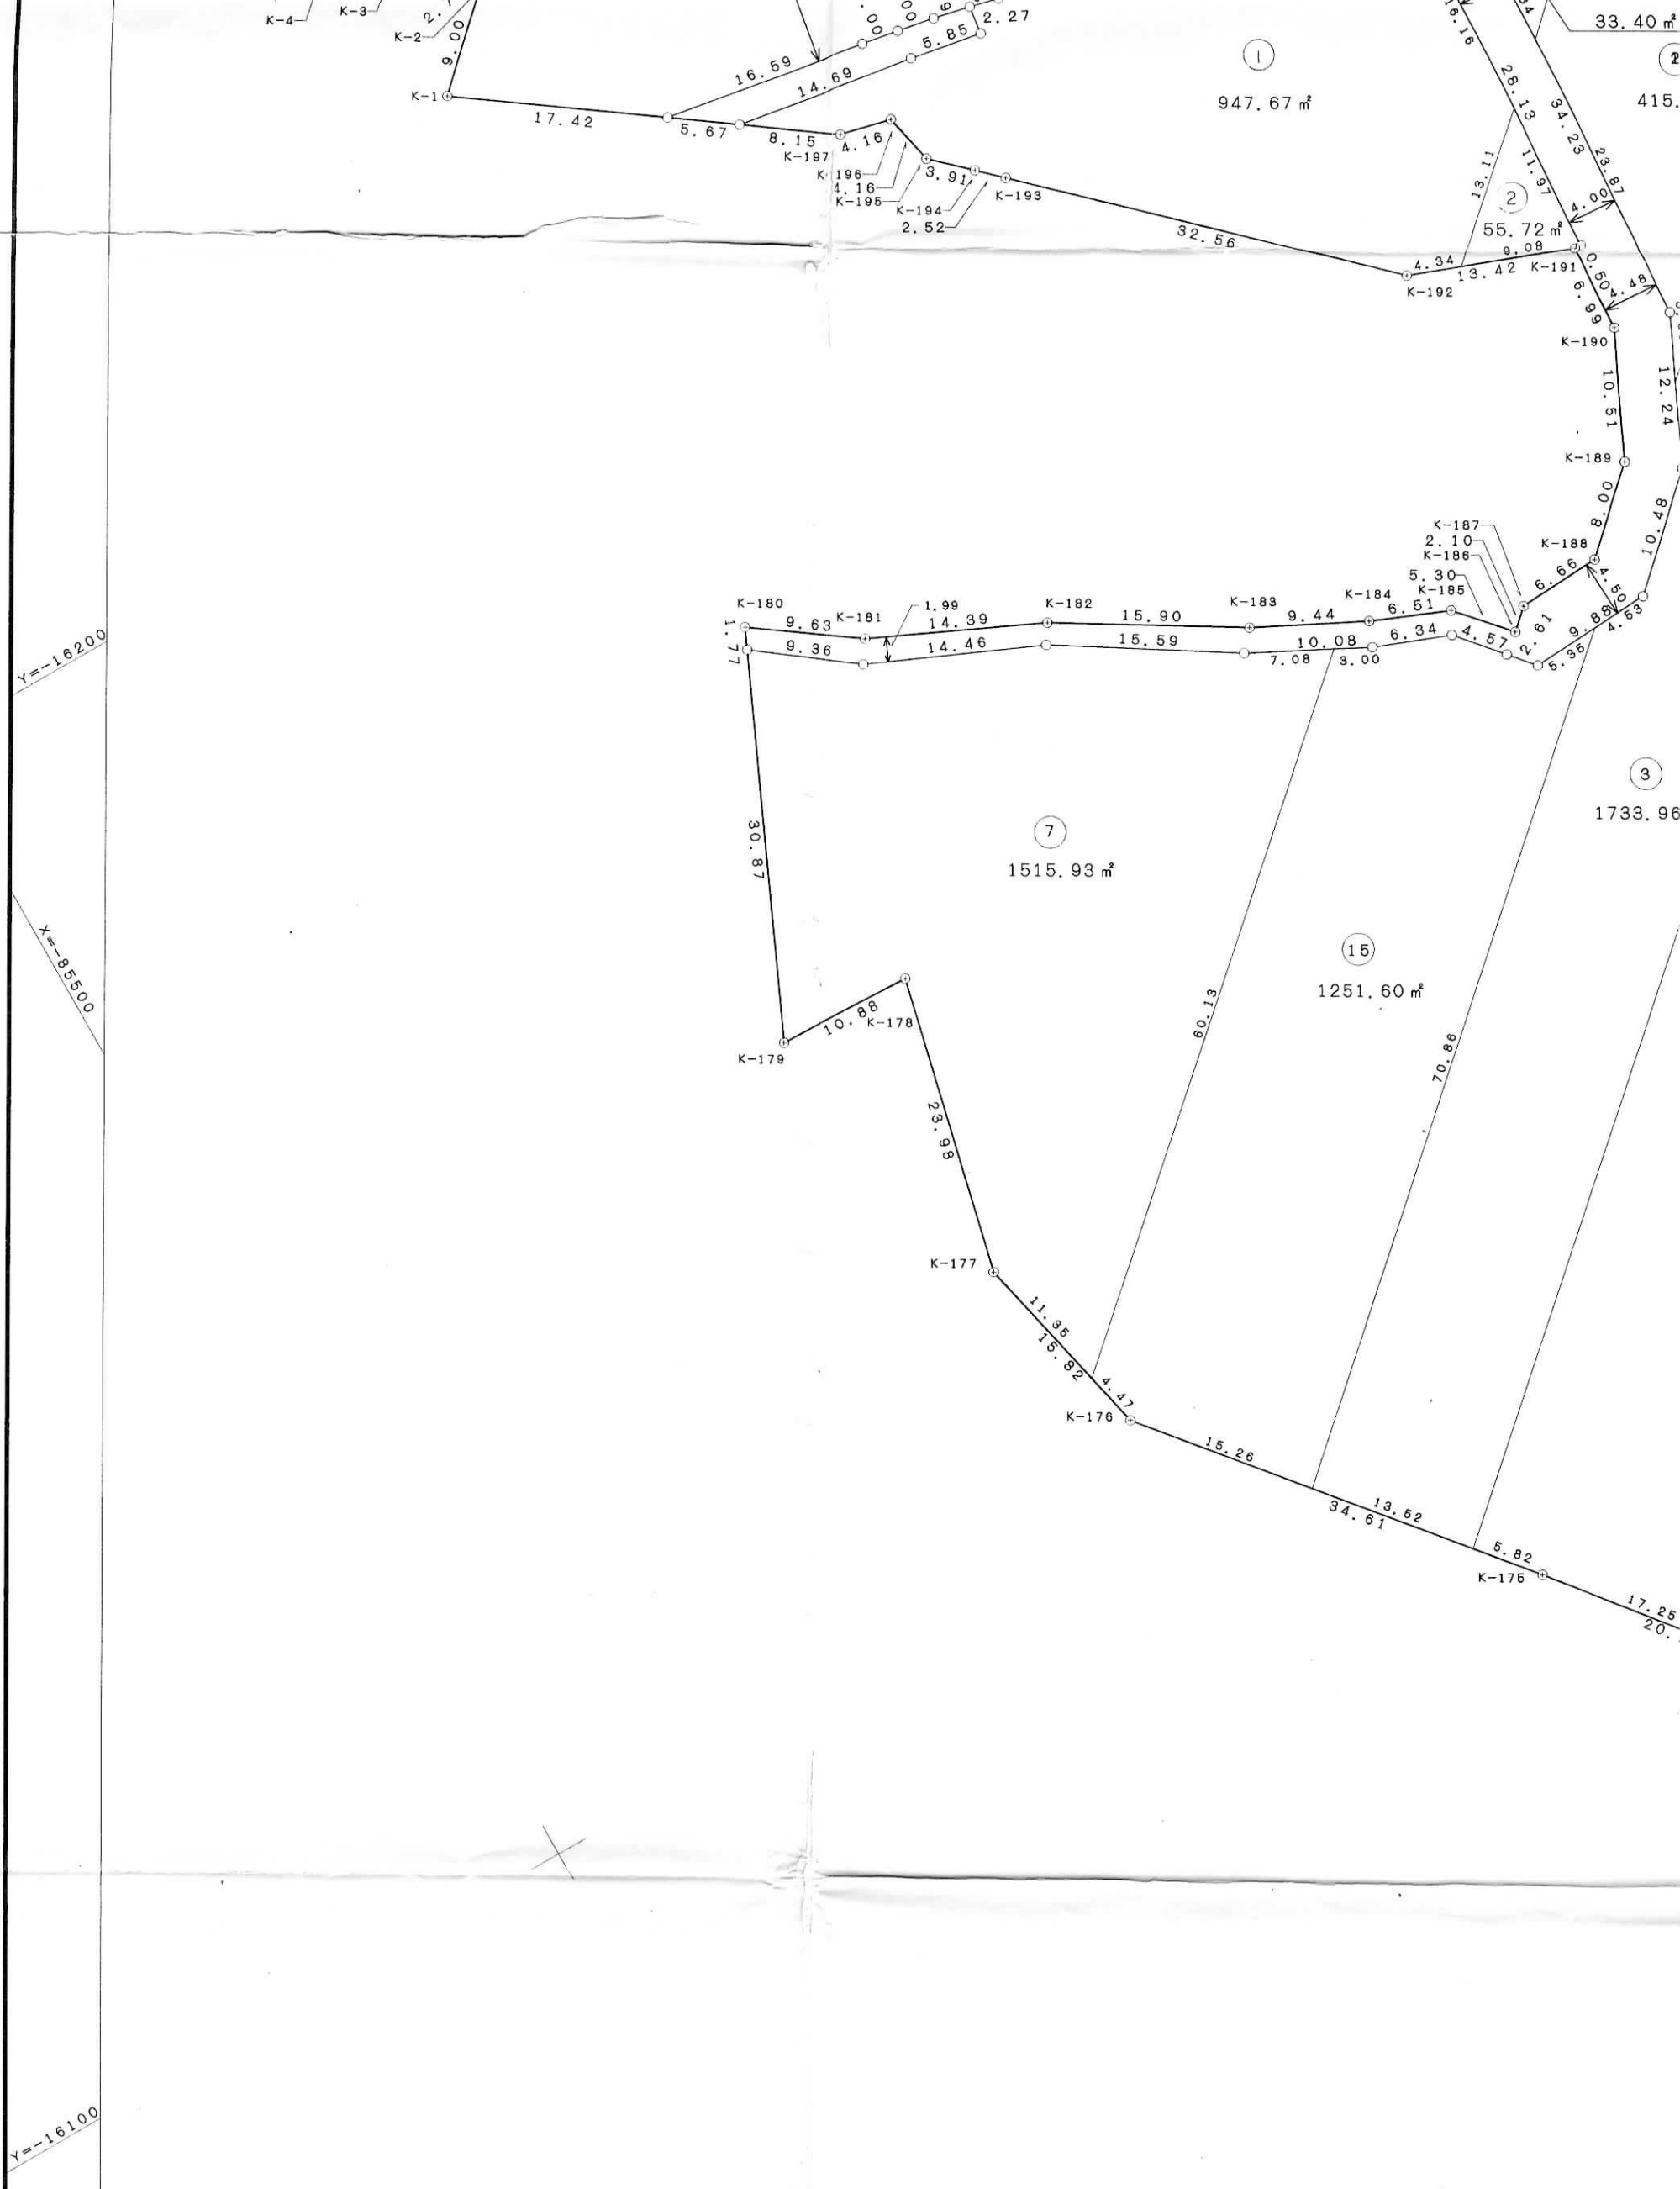


図面番号：2

図面番号：3


X=85300

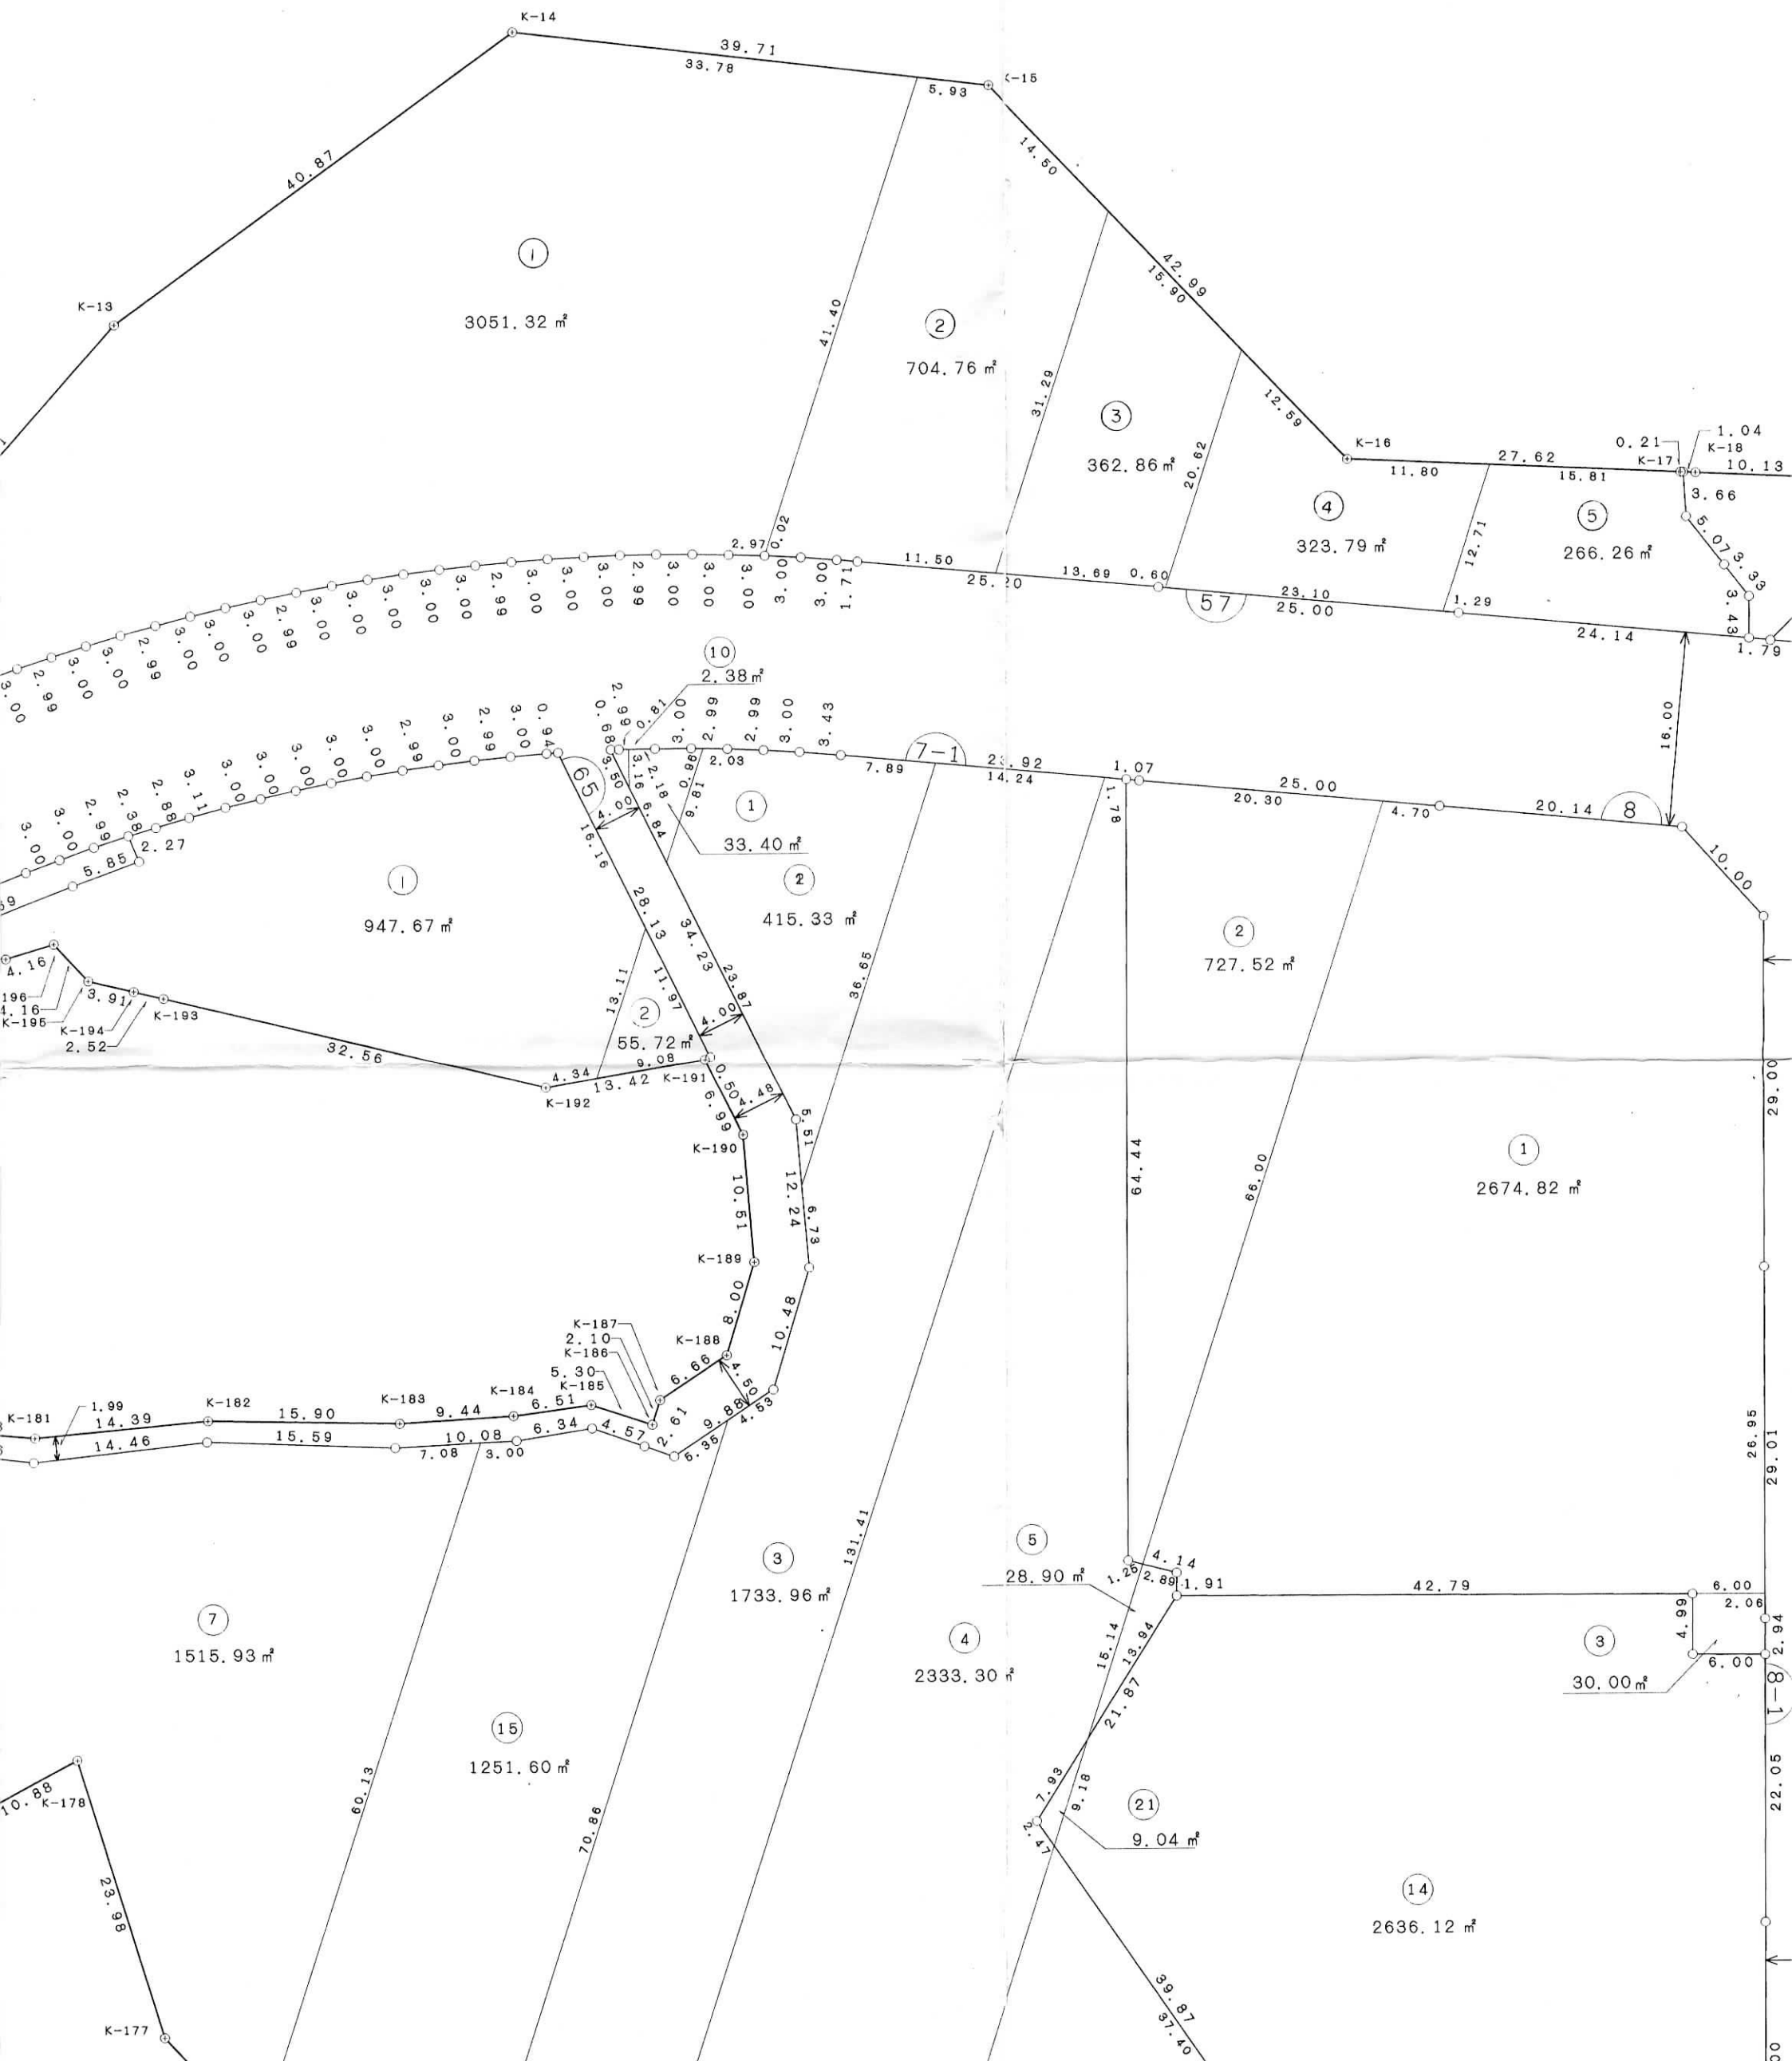



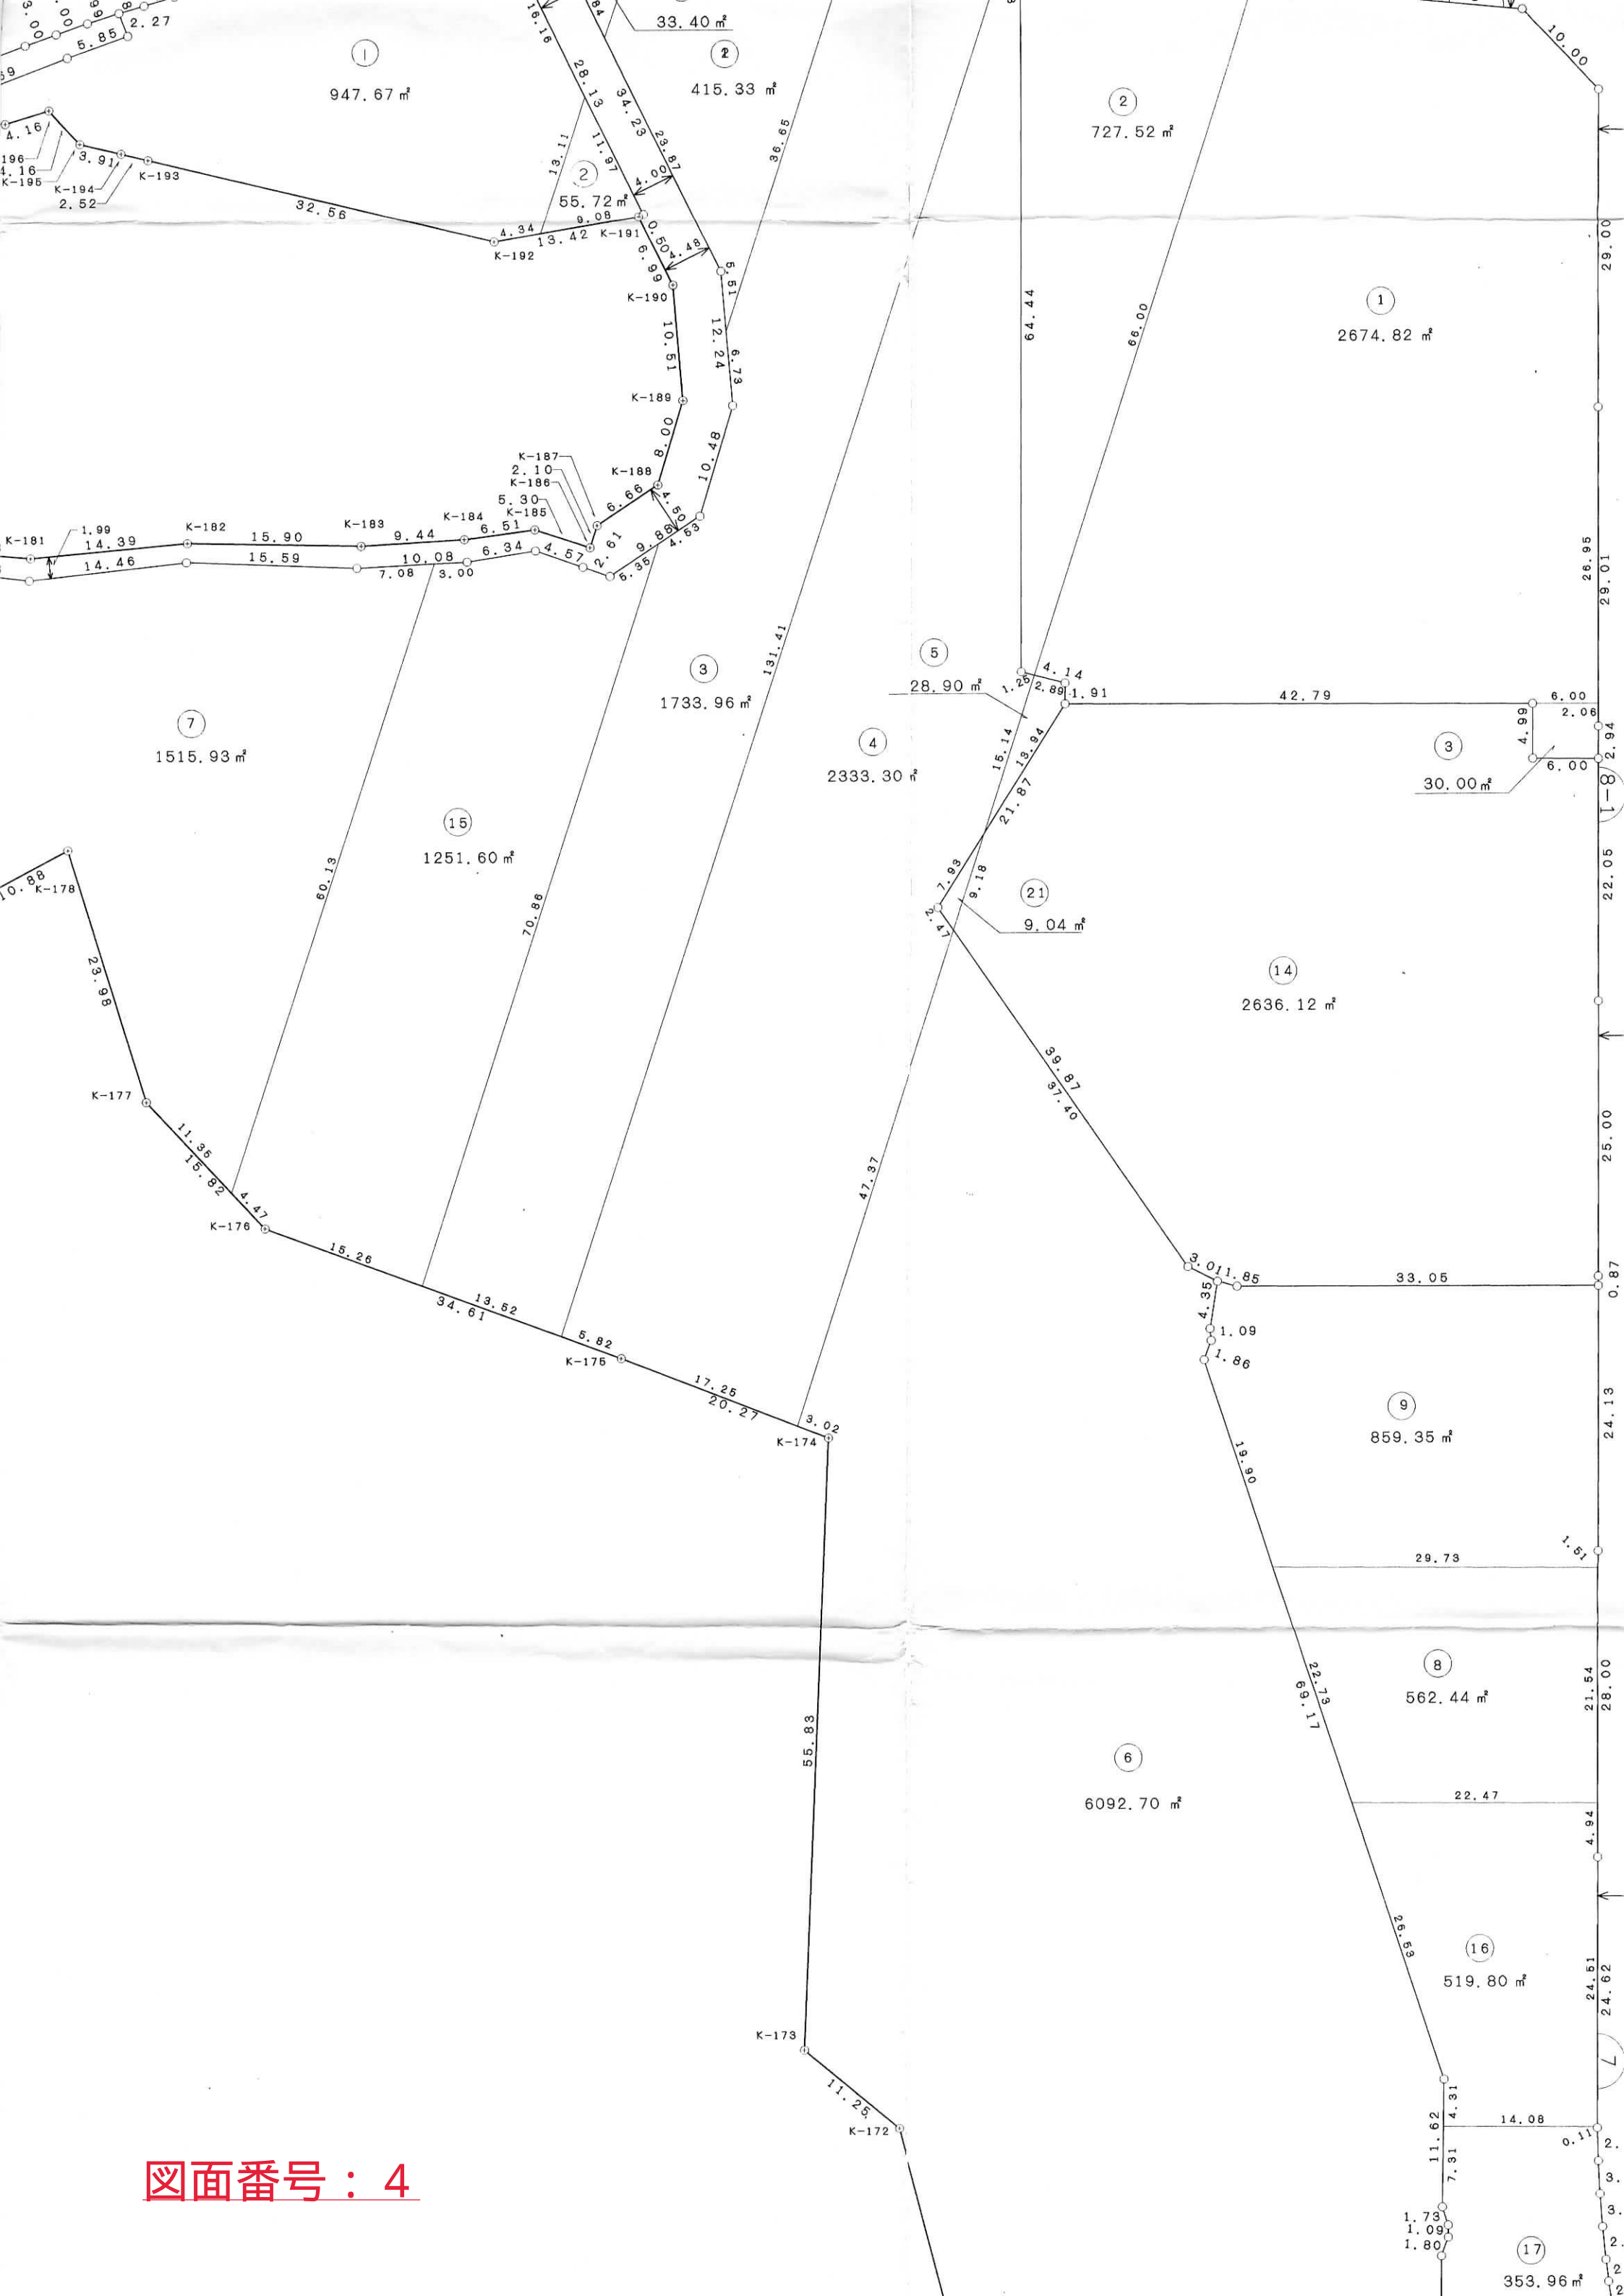

図面番号：4

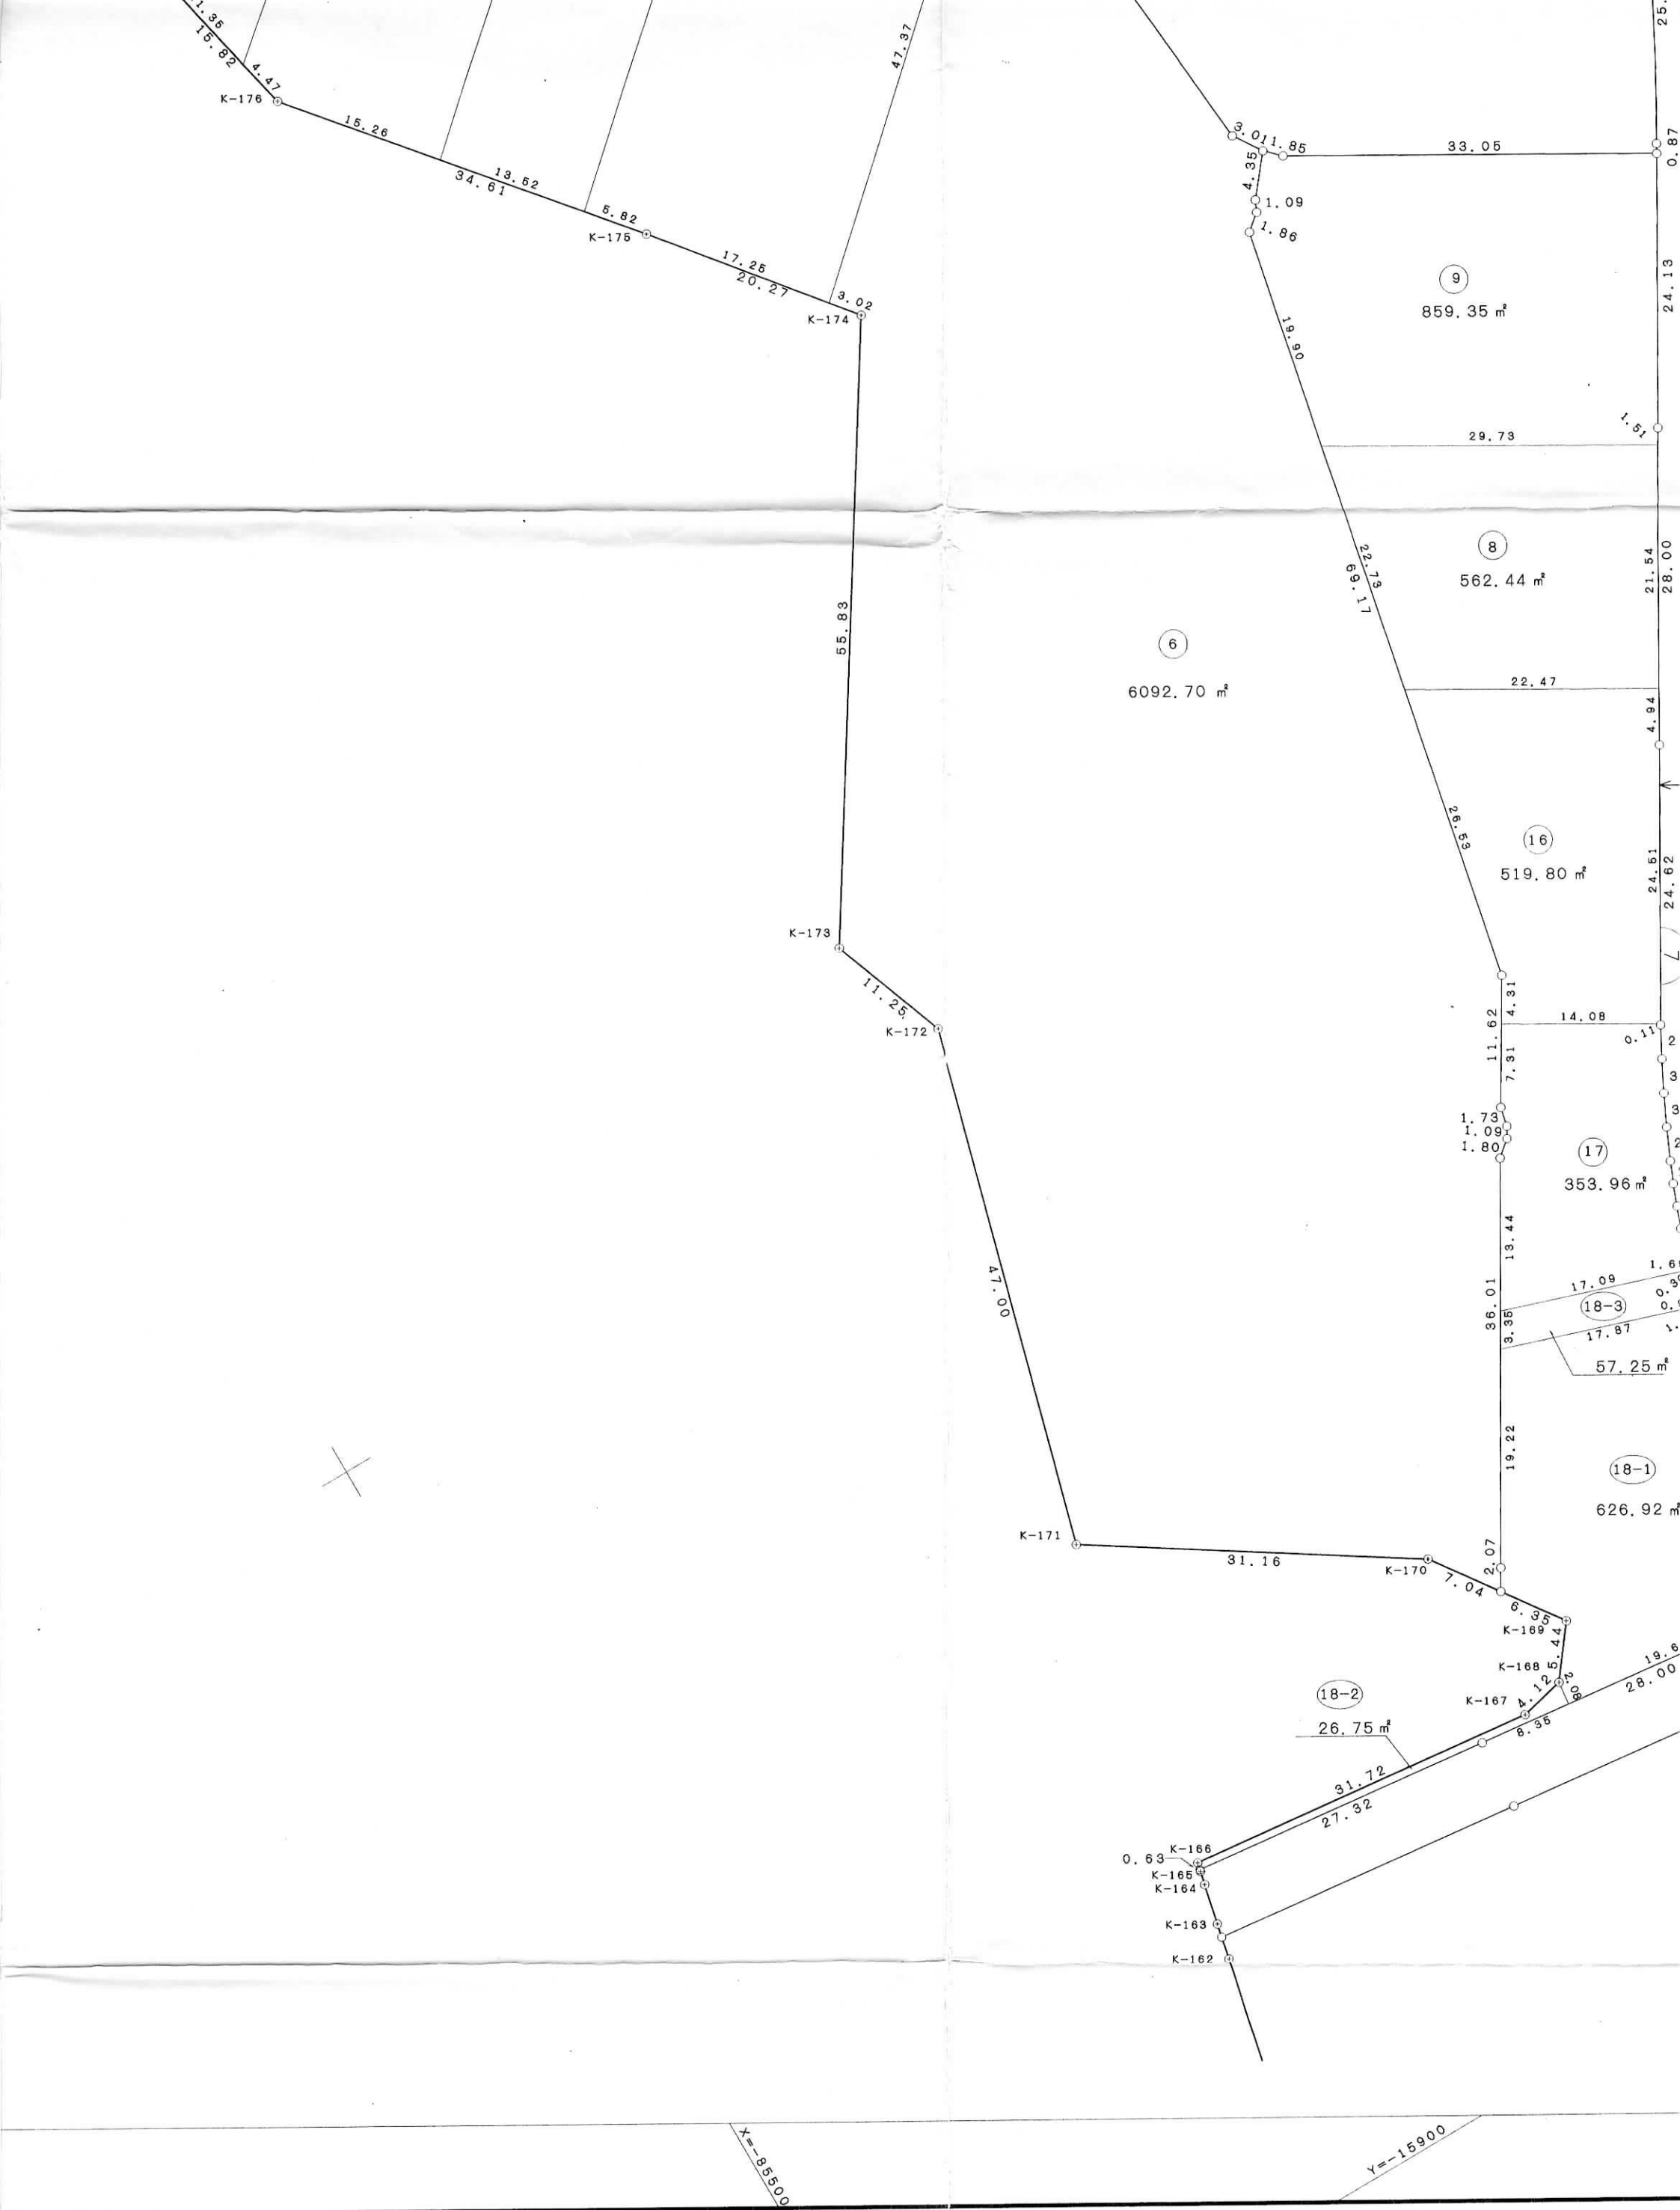

図面番号：5


# 横須賀市衣笠・太田和地区画地

図面番号：6

Y=-16200  
X=-85200





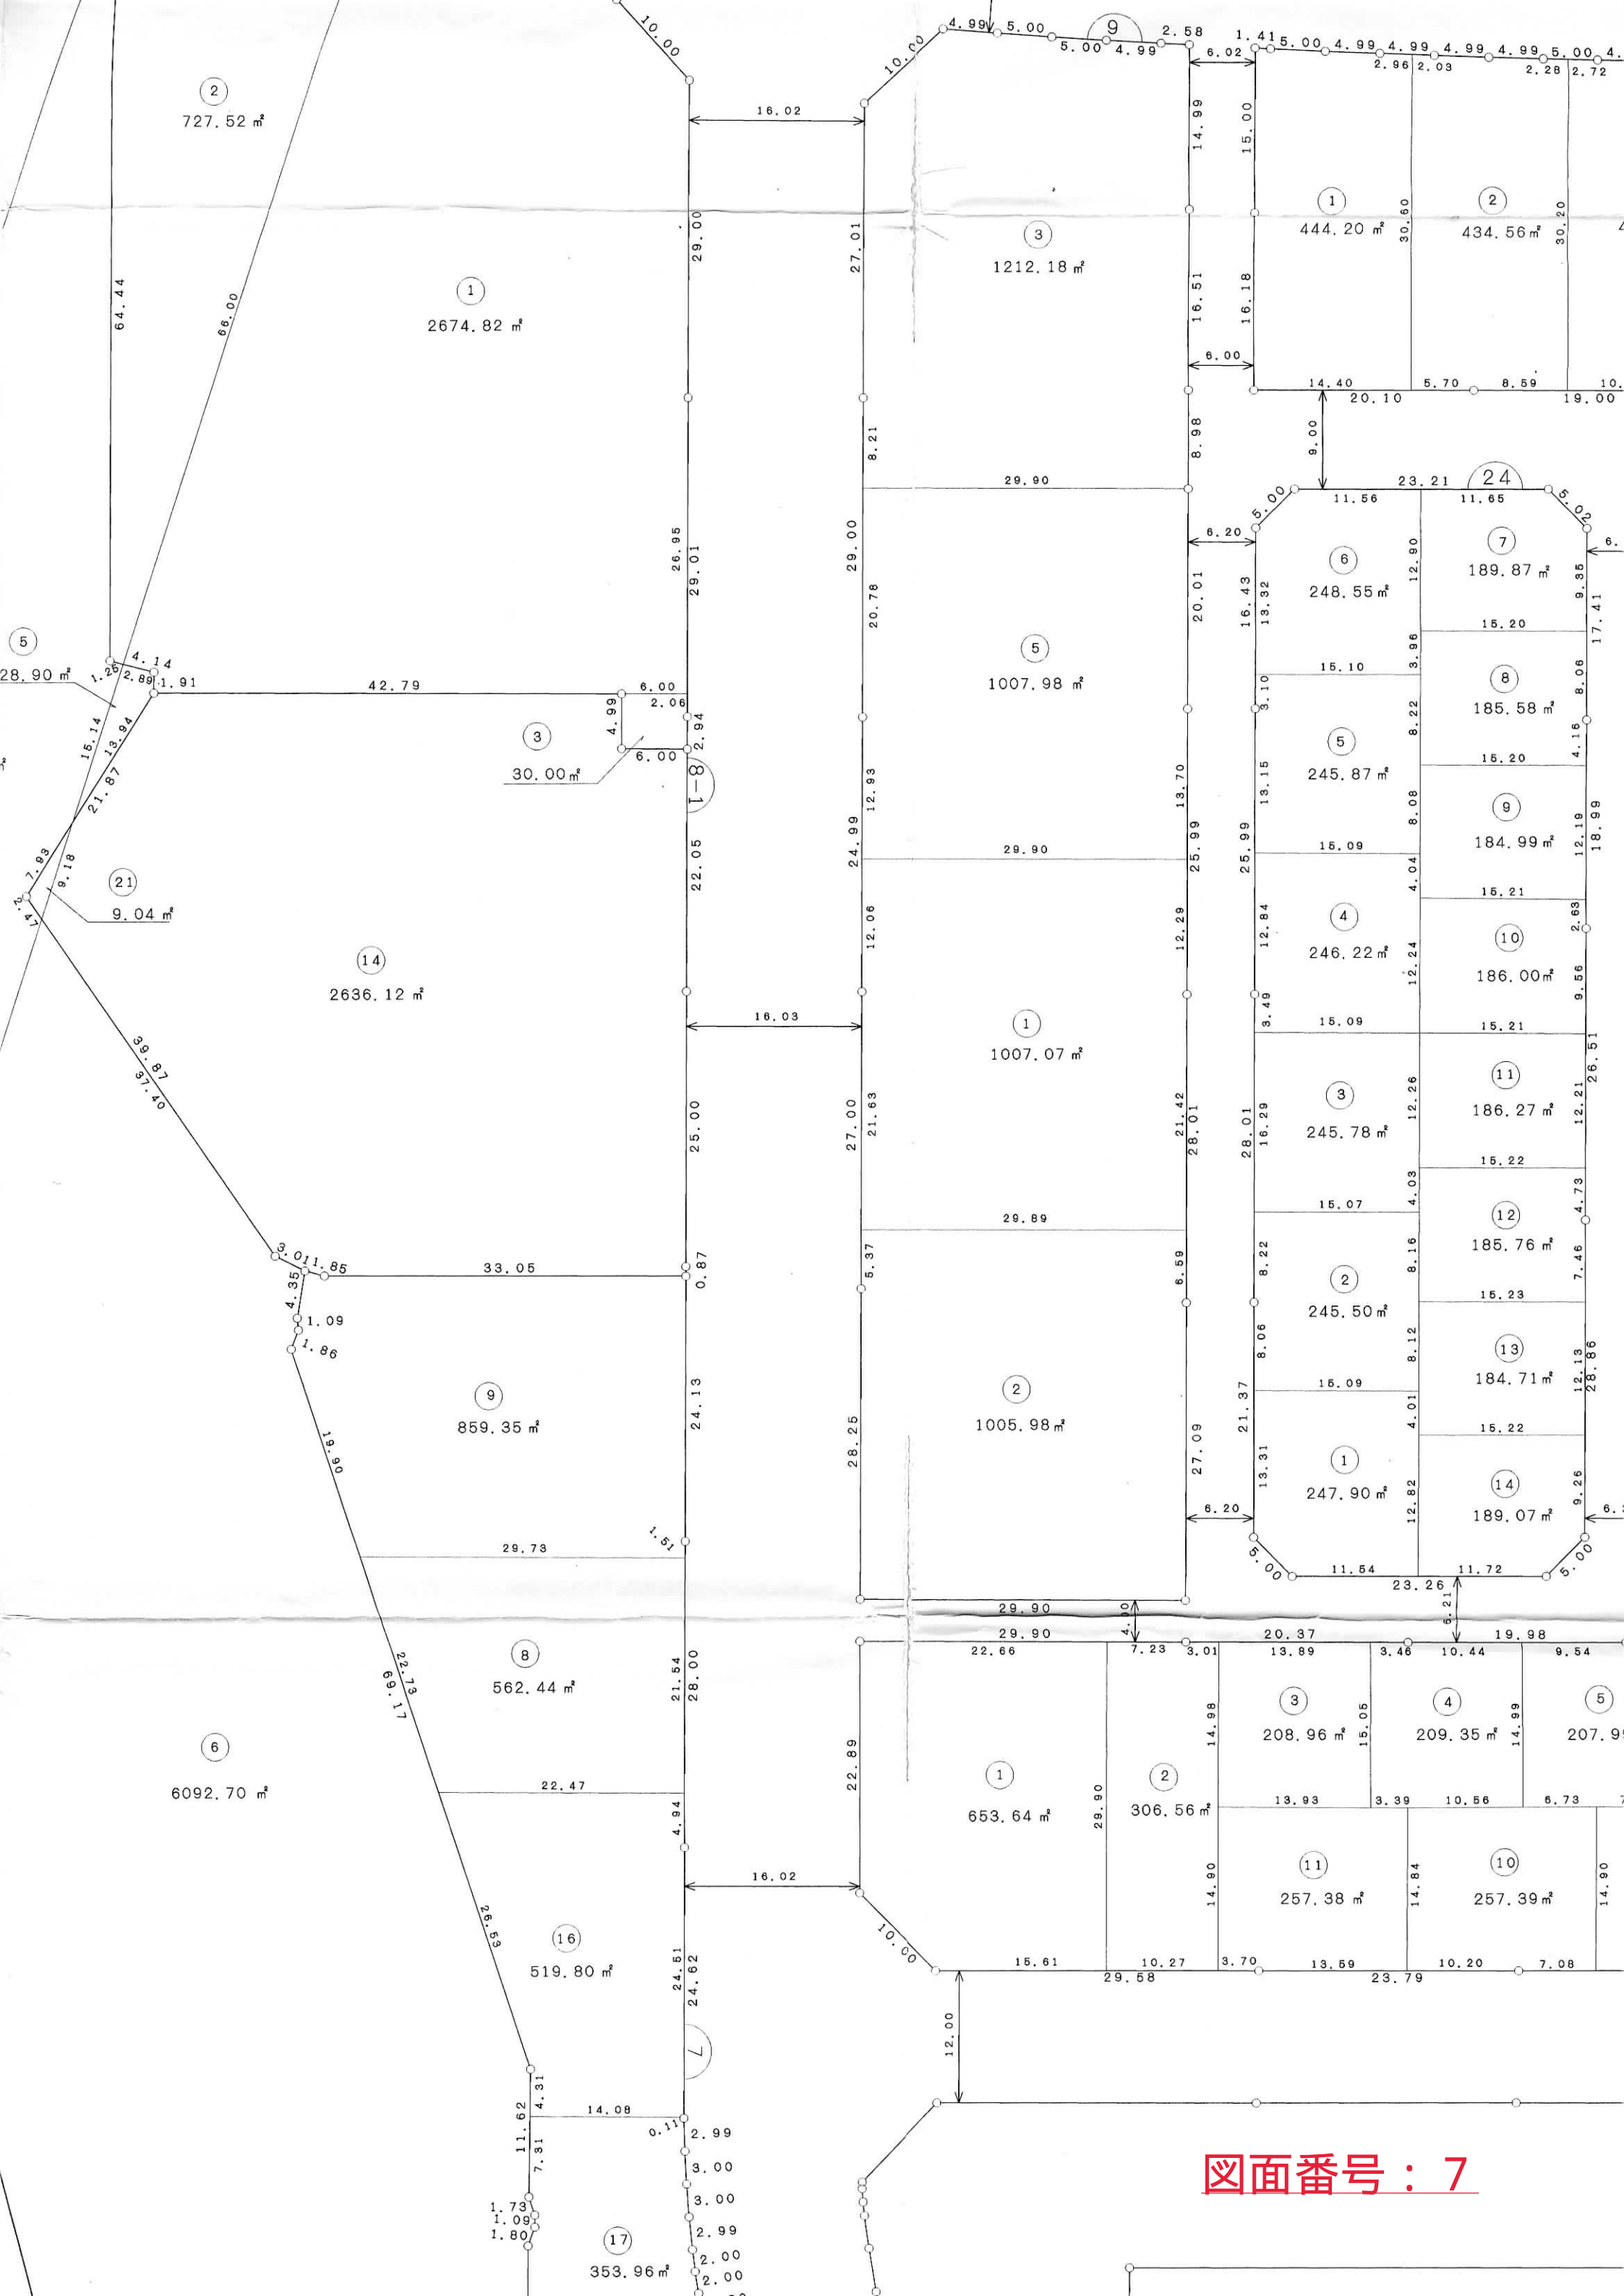

図面番号：7





# 太田和地区画地出来形確認測量原図

図面番号：9

X=85100








# 形確認測量原図

縮尺 1 : 500

図面番号 : 11






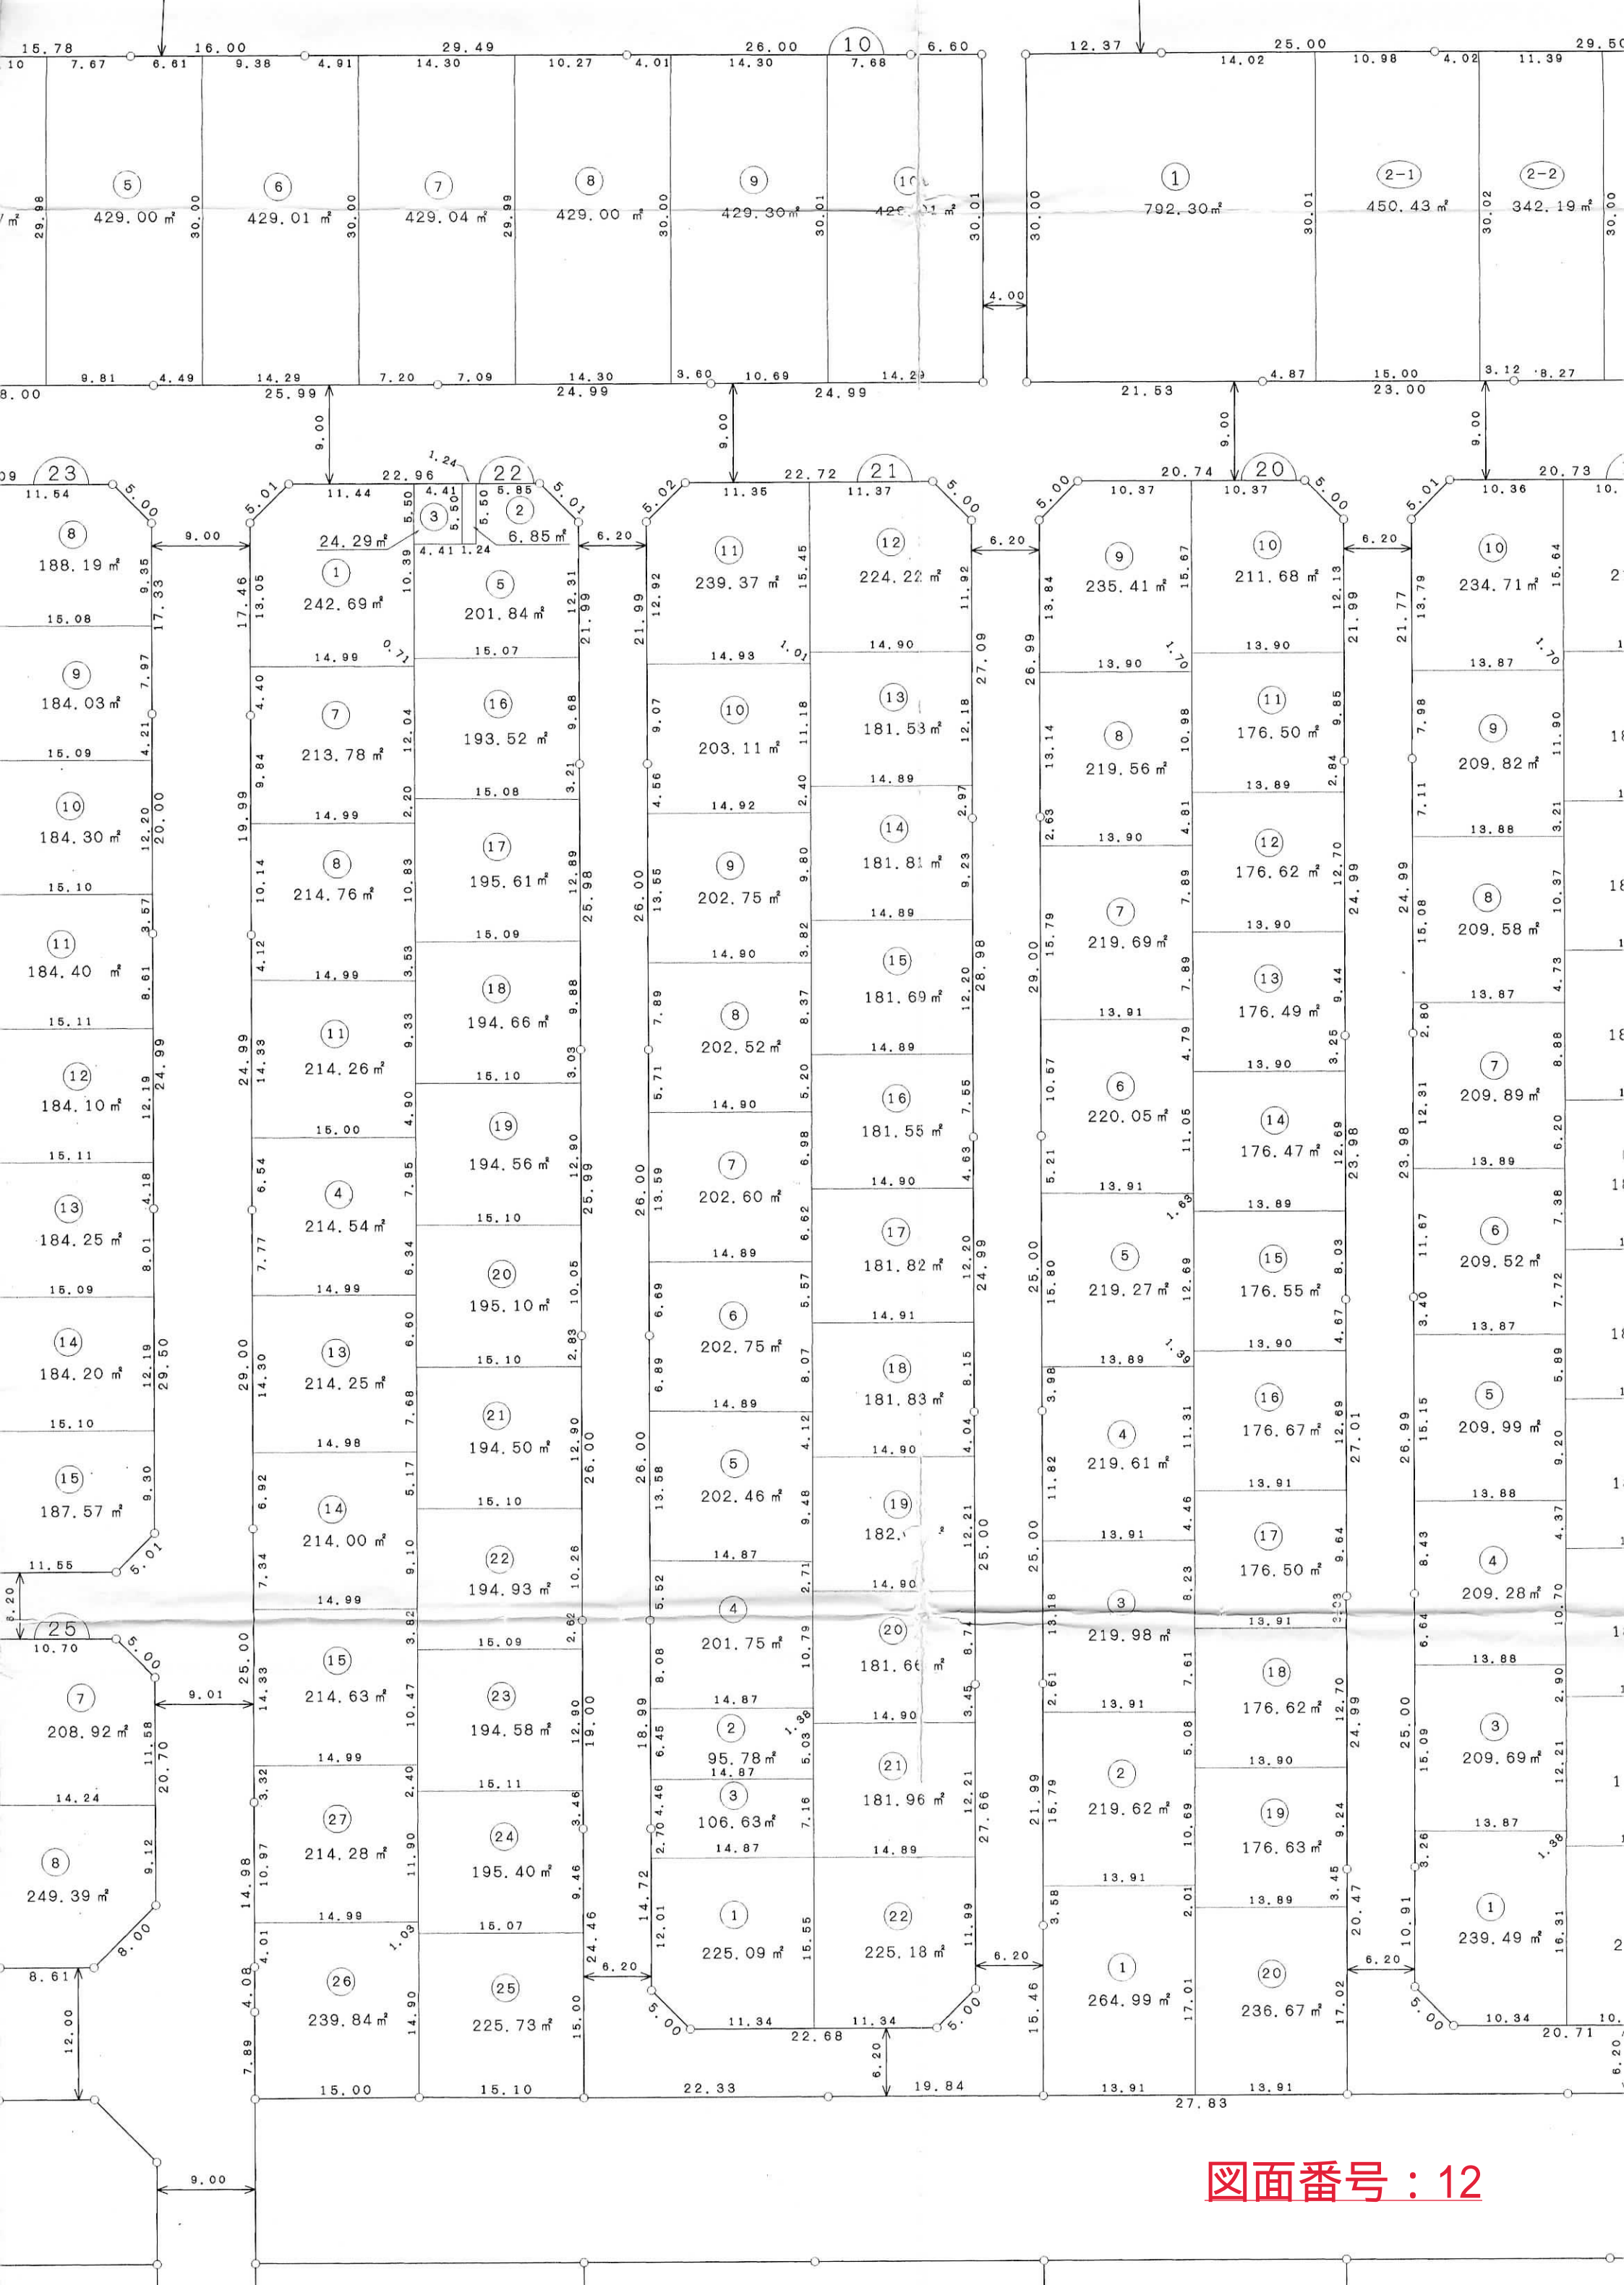

図面番号：12

図面番号 : 13

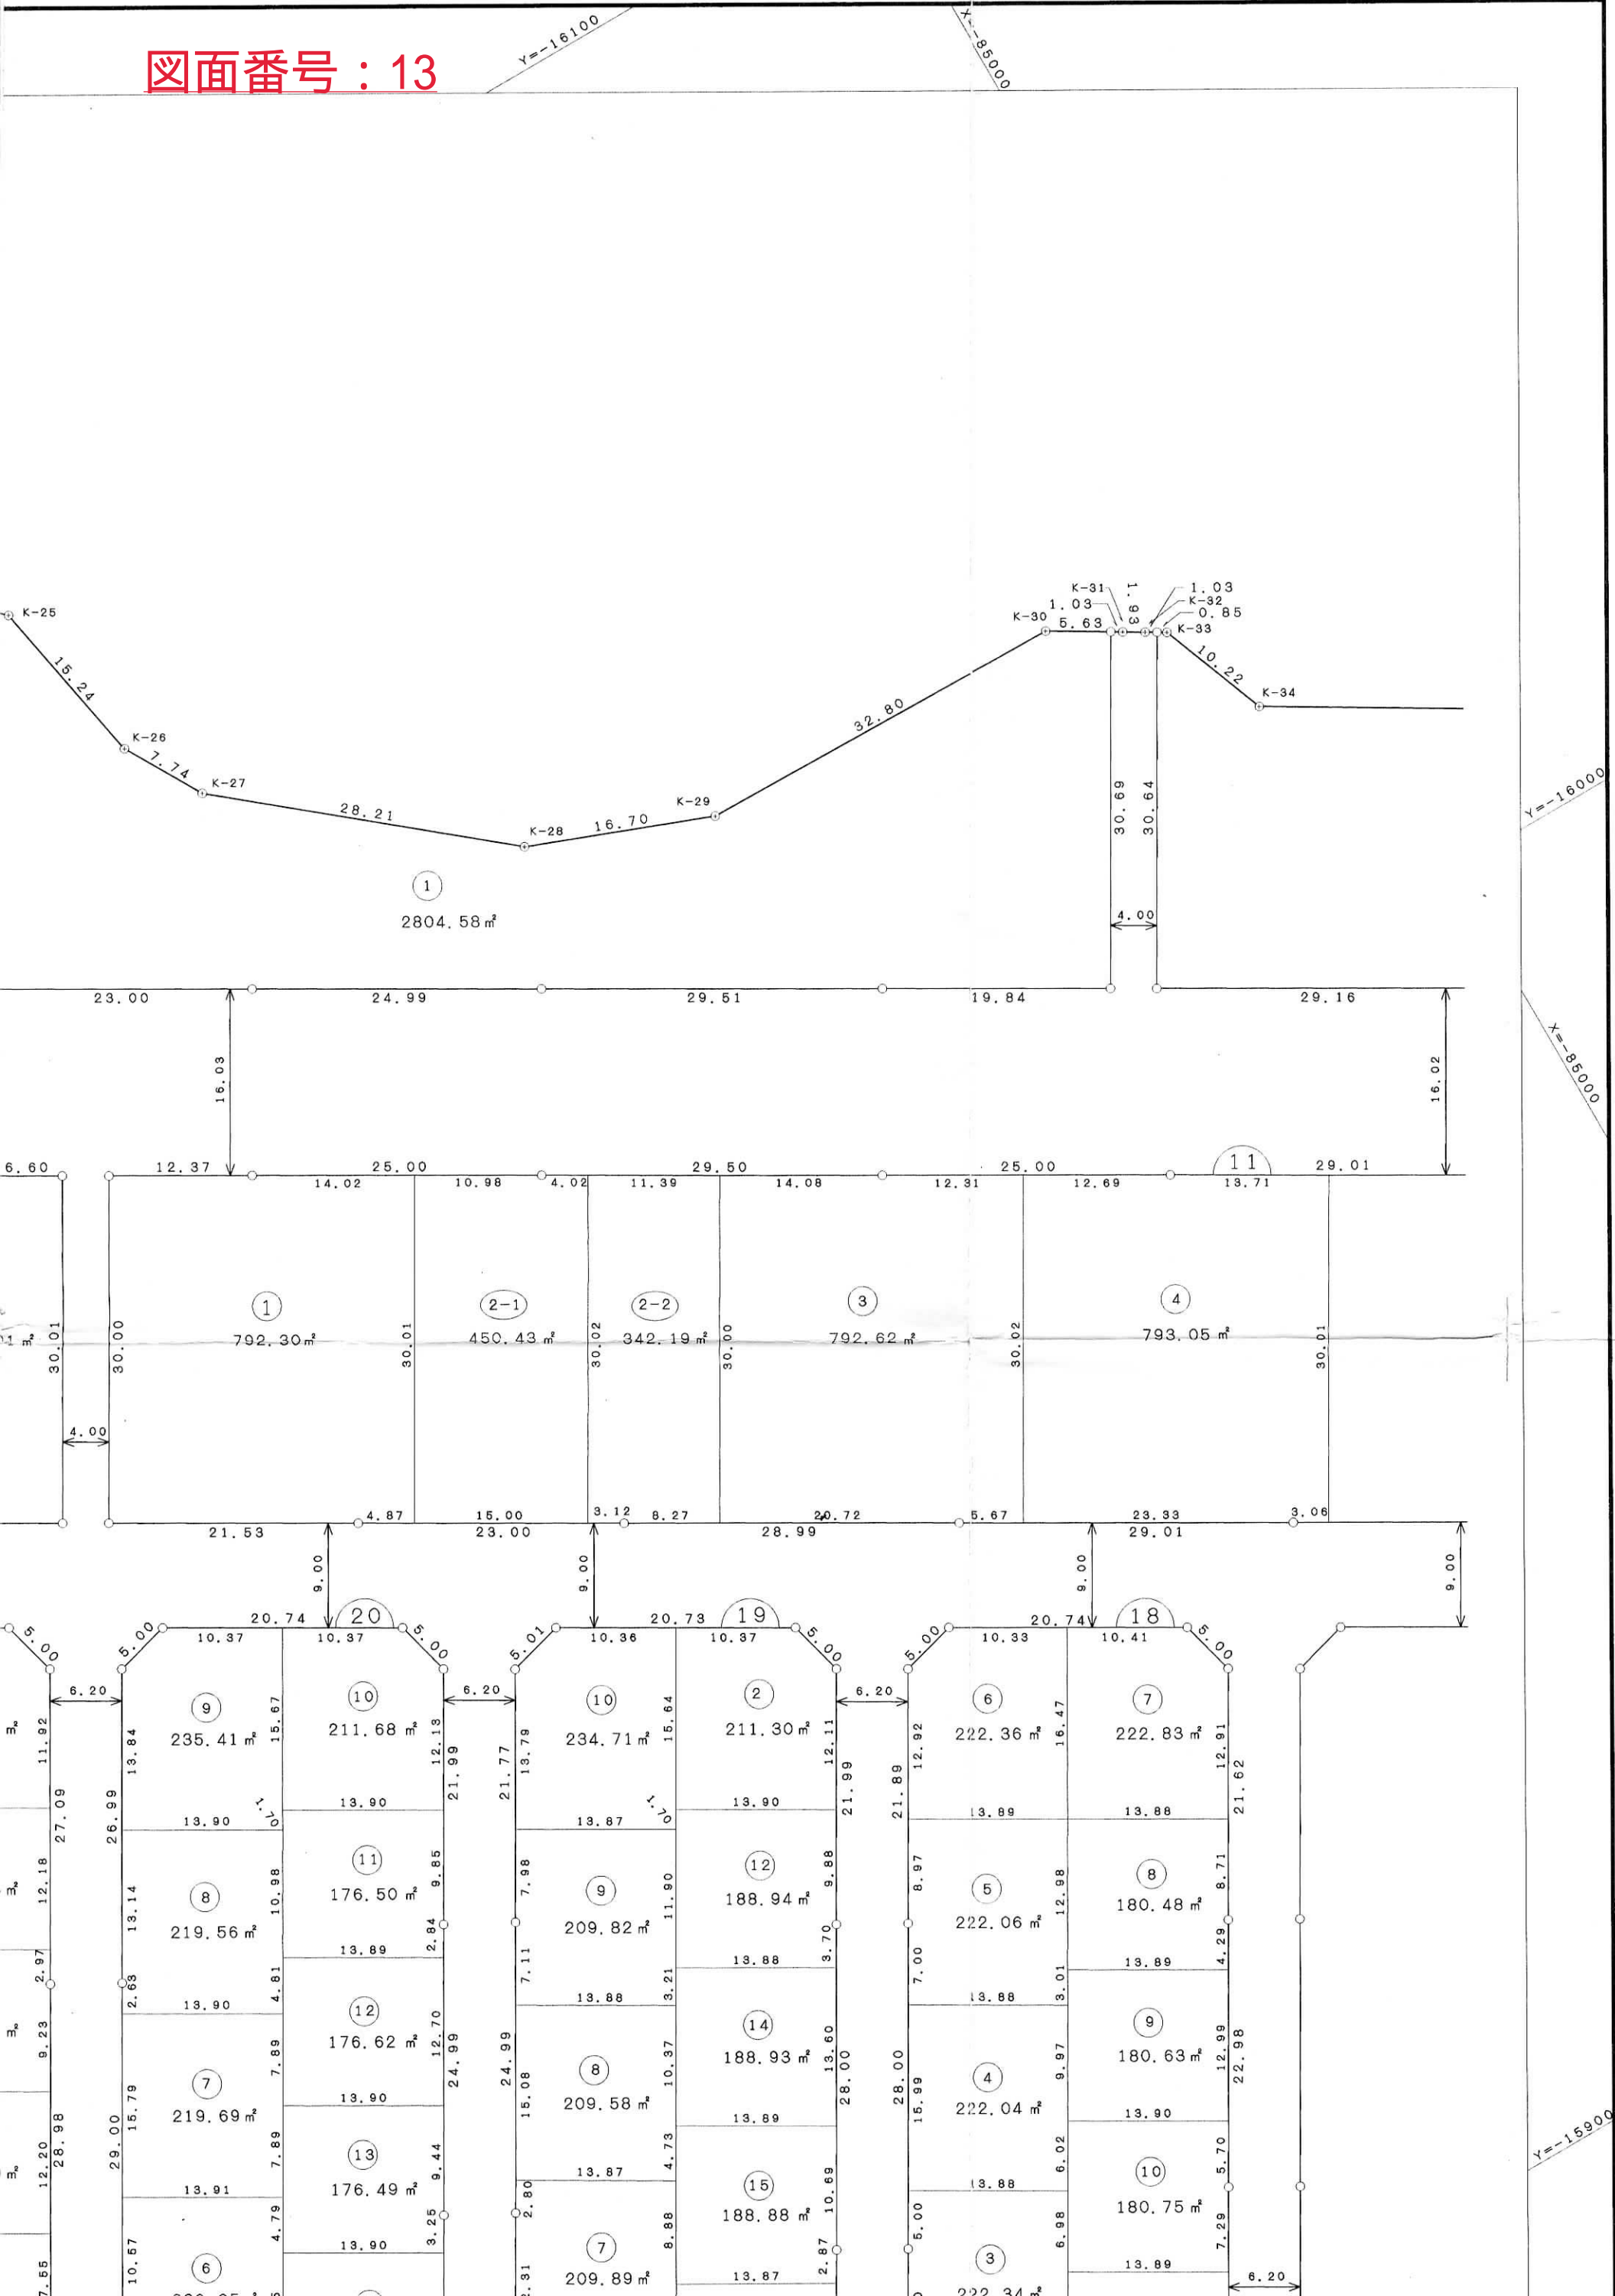





図面番号: 14

X=-85100  
Y=-15800