



# 横須賀市衣笠・太田和地区画地出来形確認測量

図面番号：26

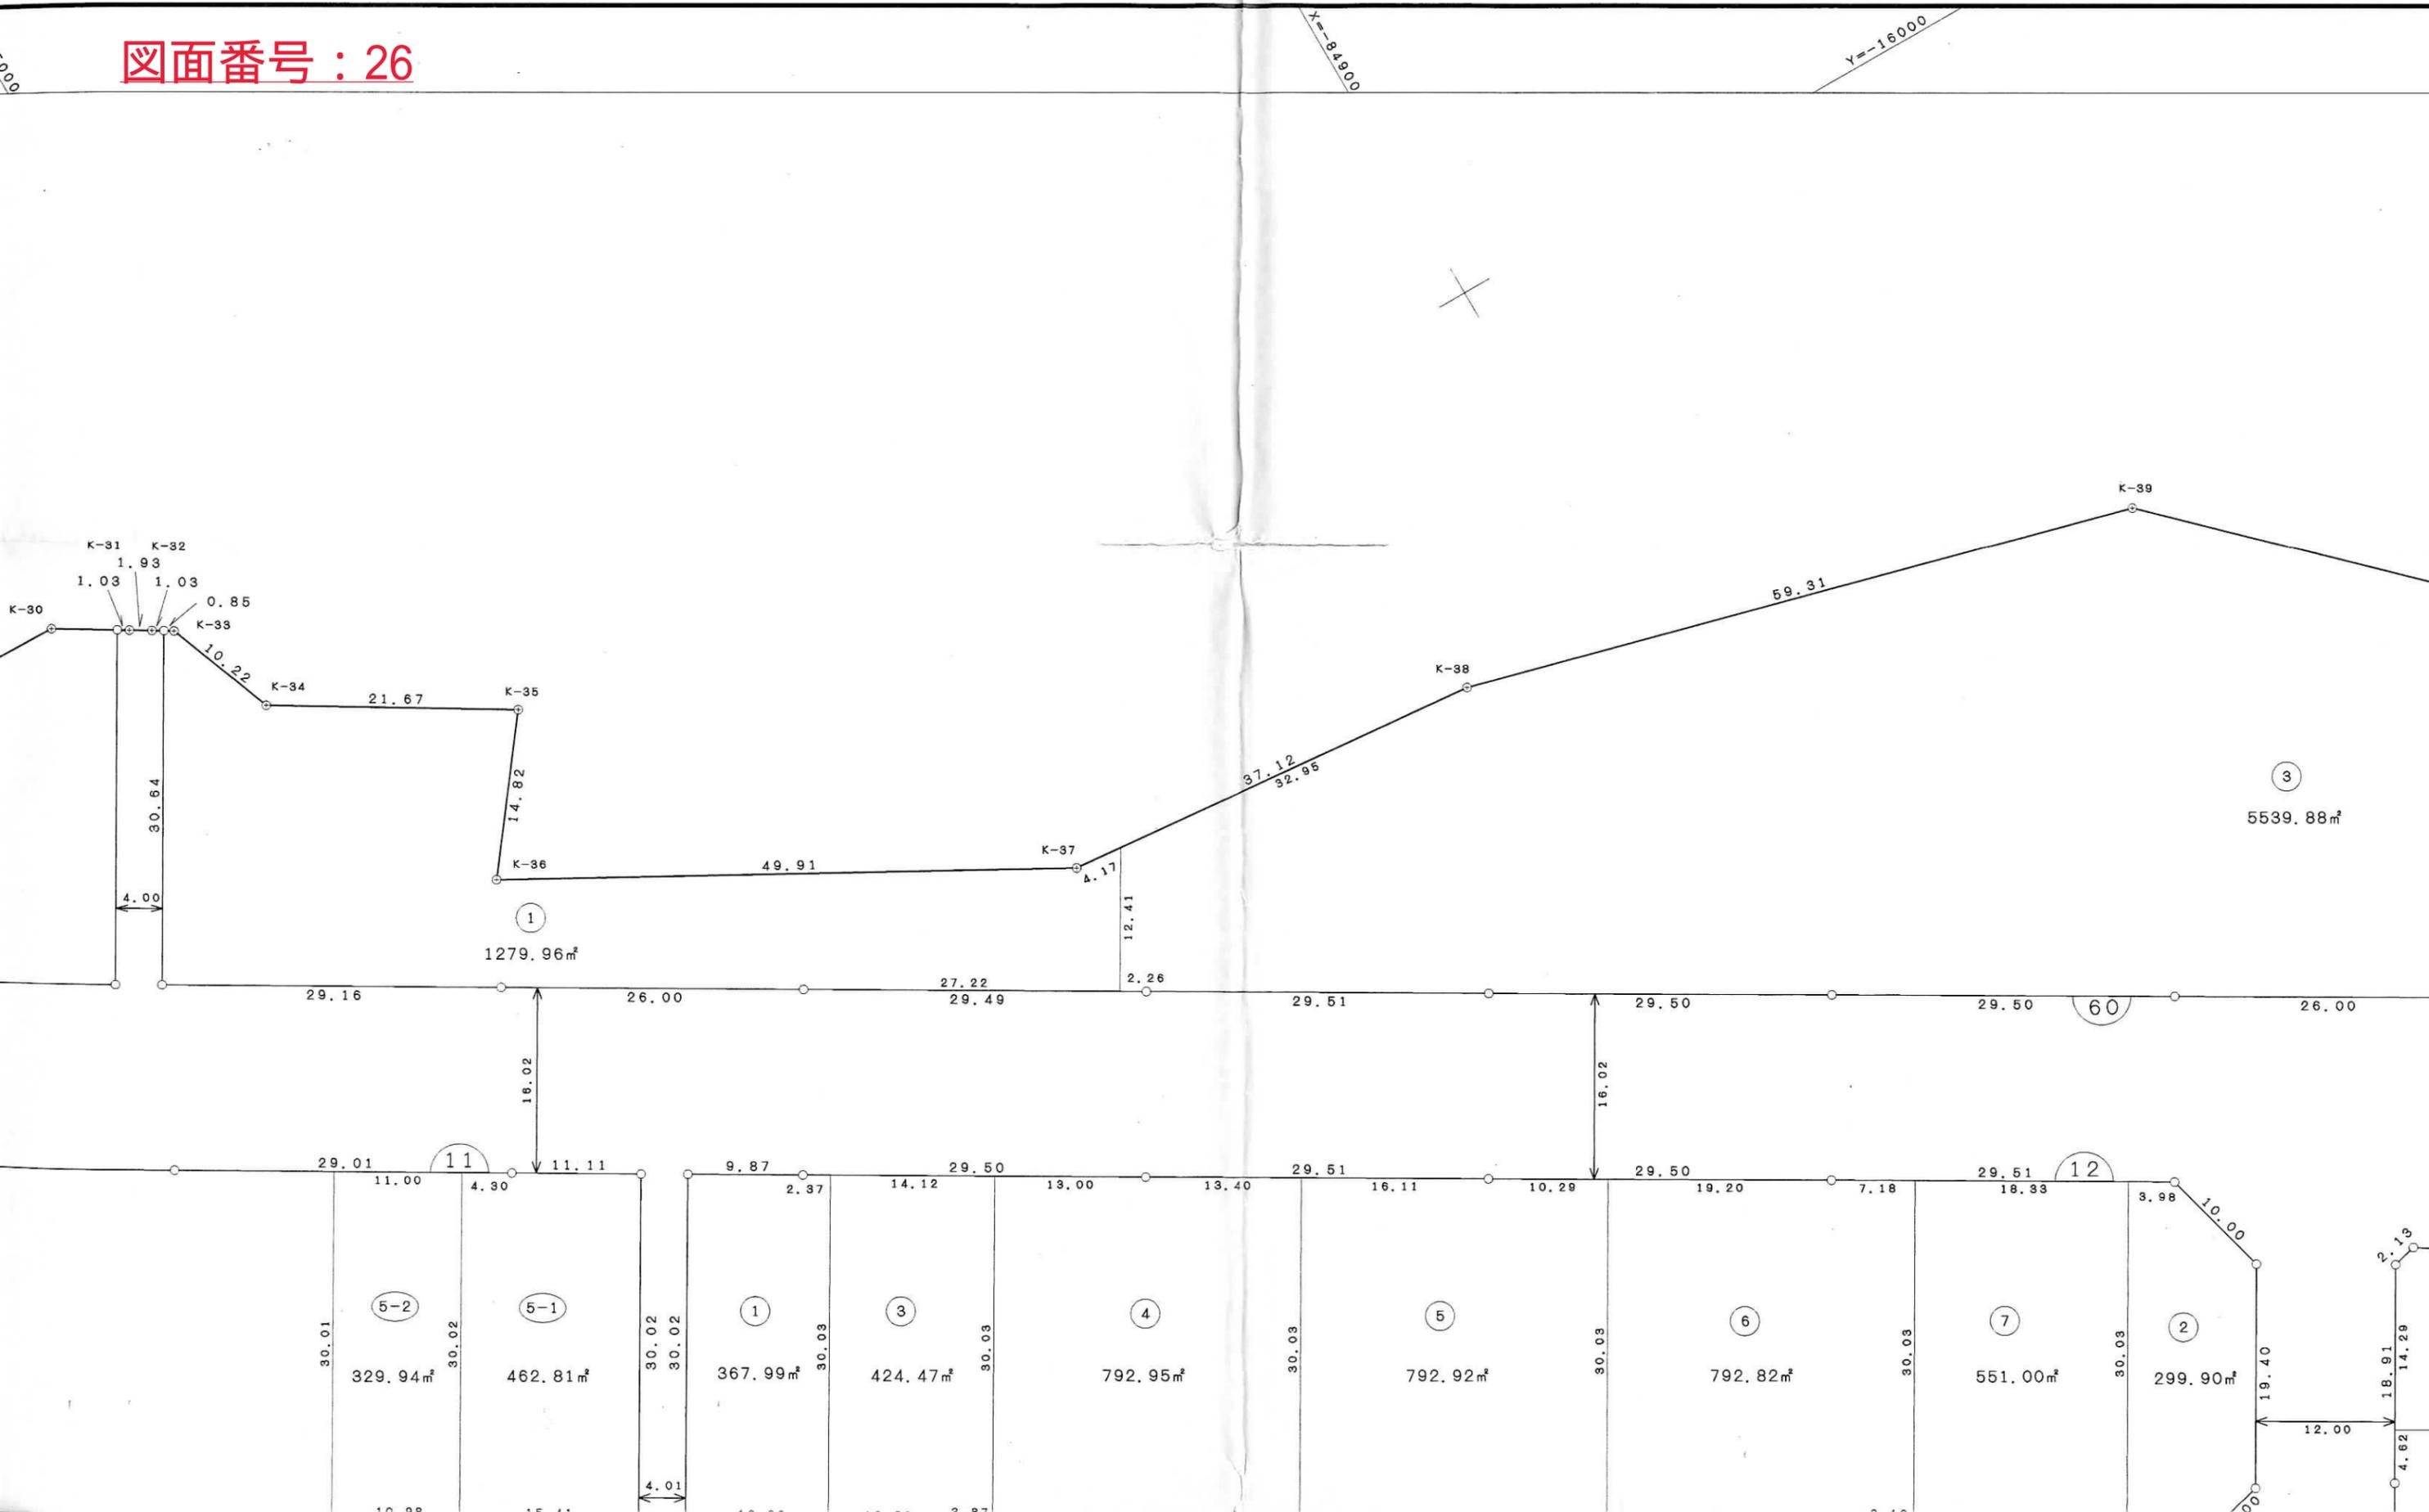


# 出来形確認測量原図

縮尺 1:500 全 4葉の3

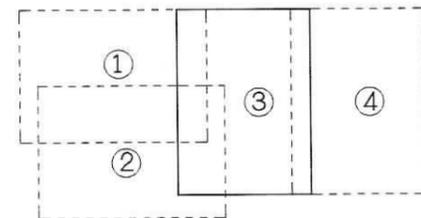

図面番号: 27

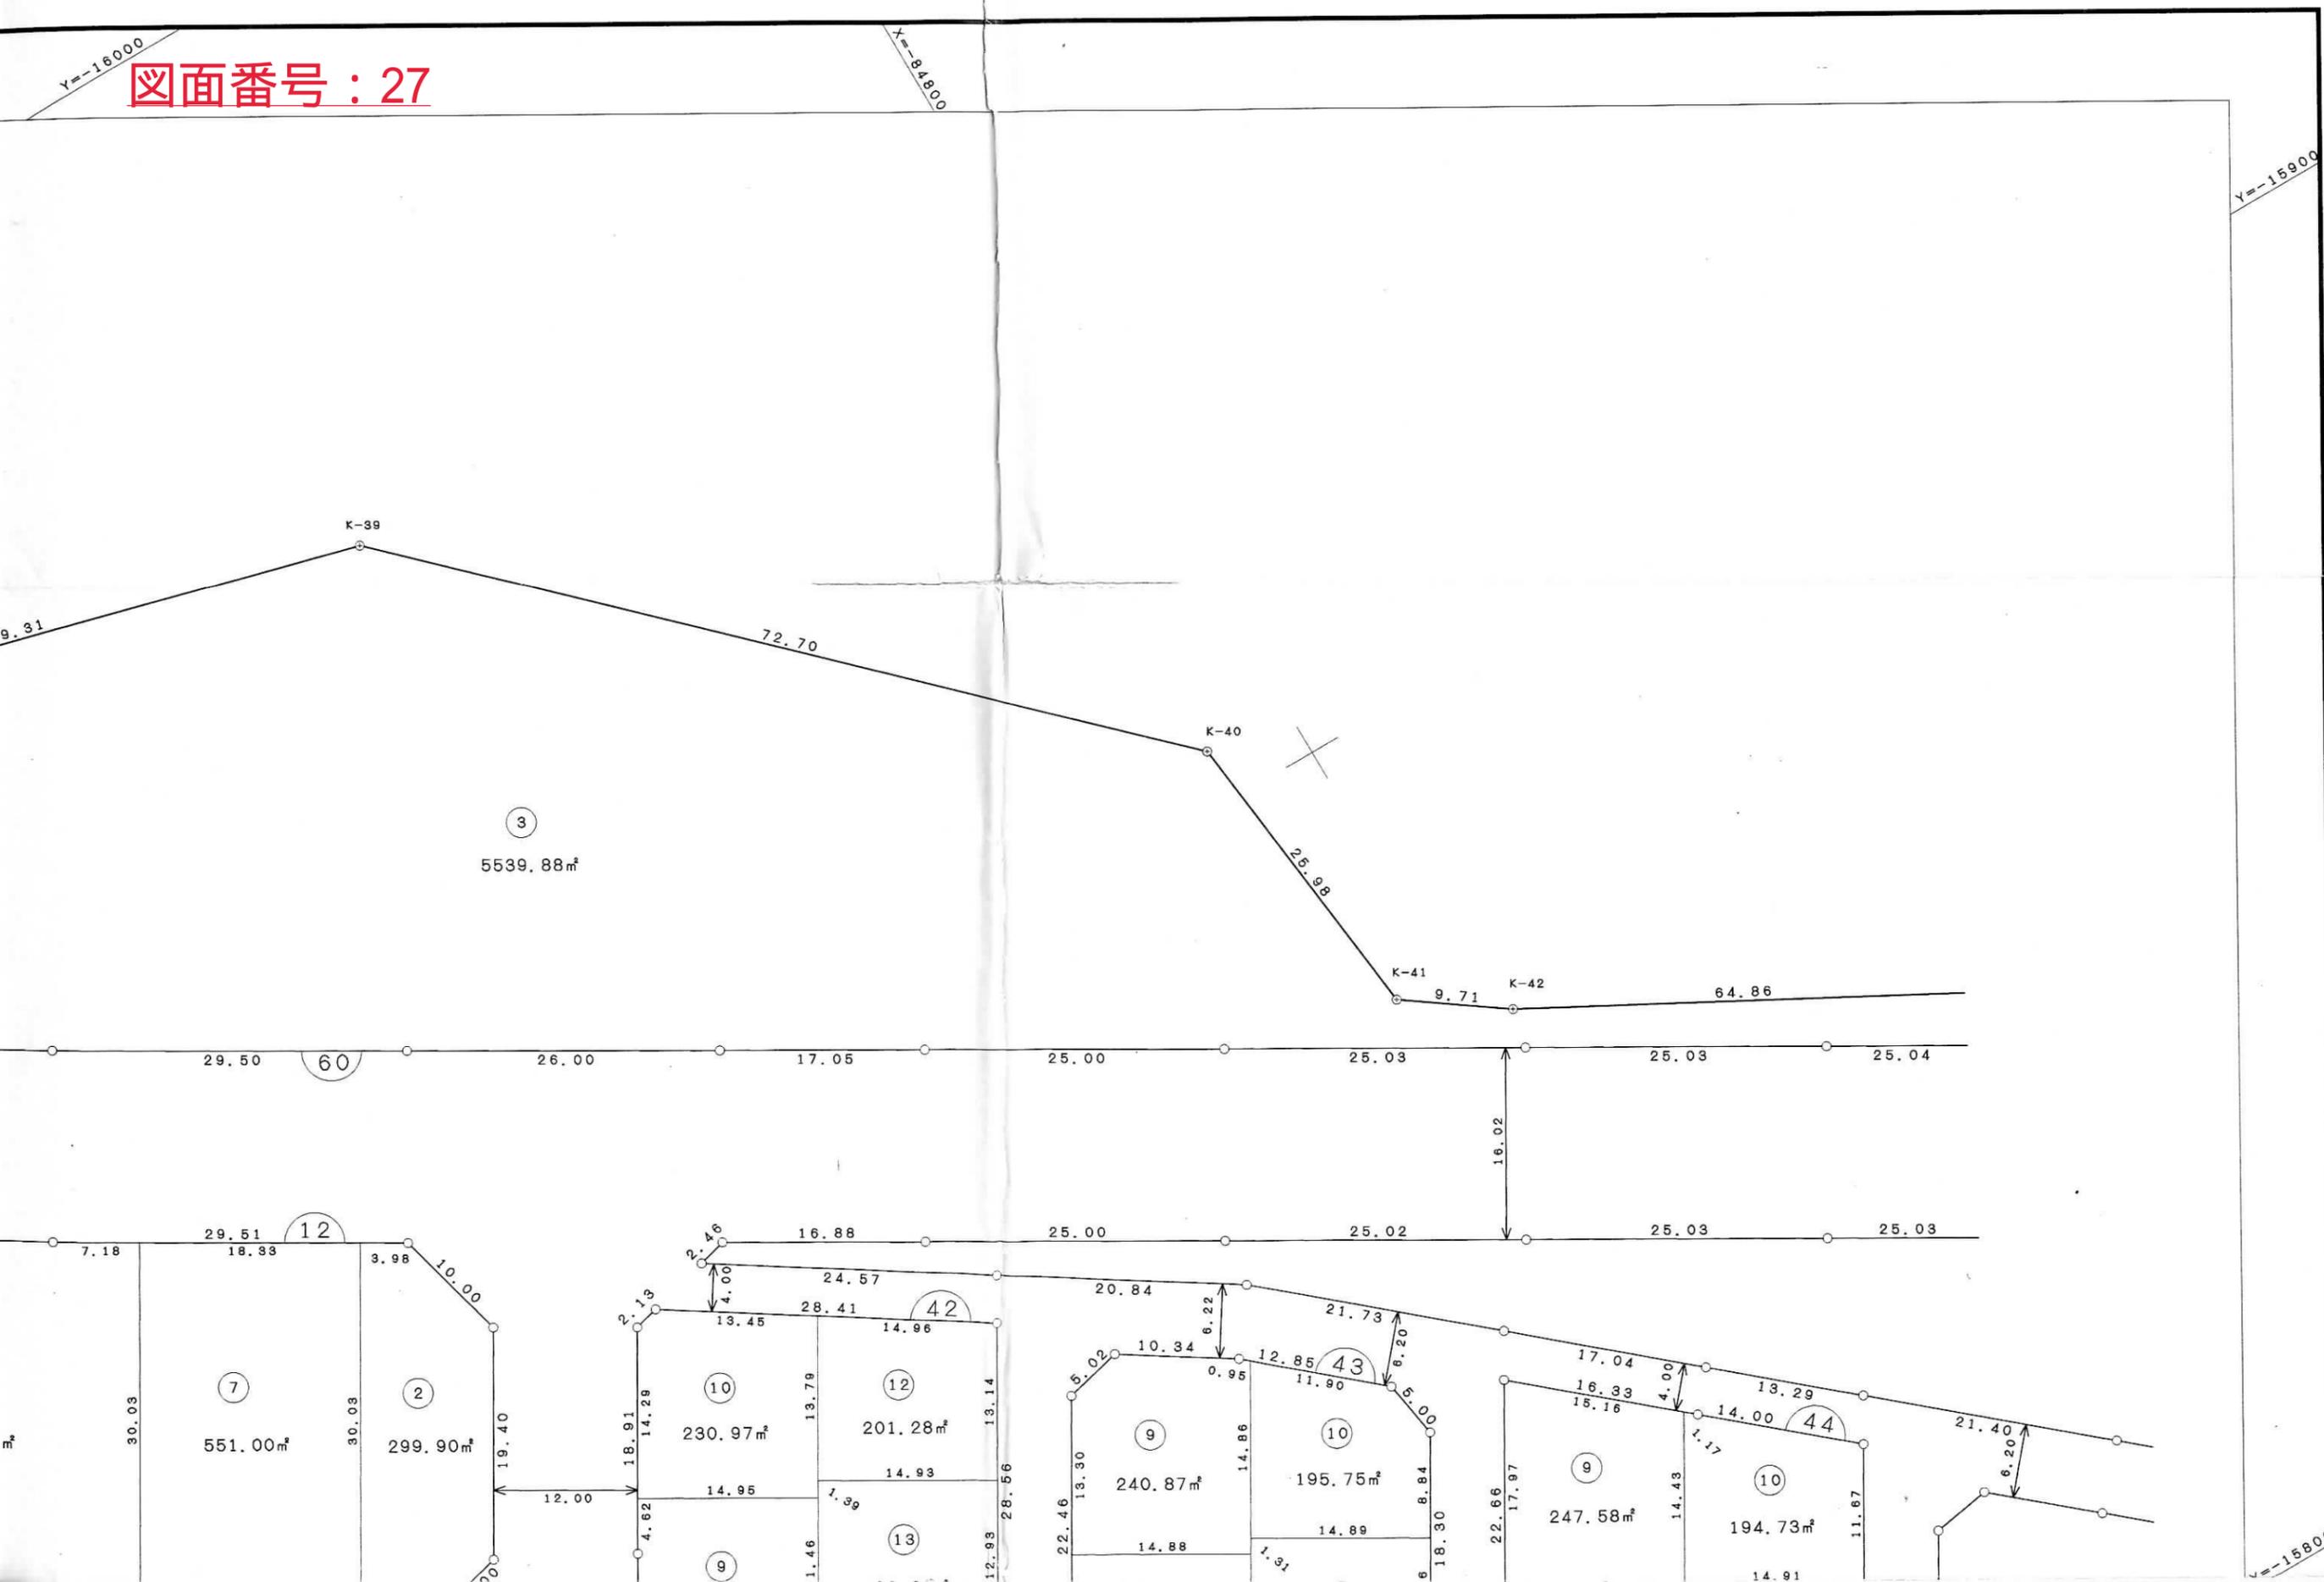



5539.88<sup>m</sup>

図面番号：29



Y=15800

X=94800


図面番号：30





図面番号: 32



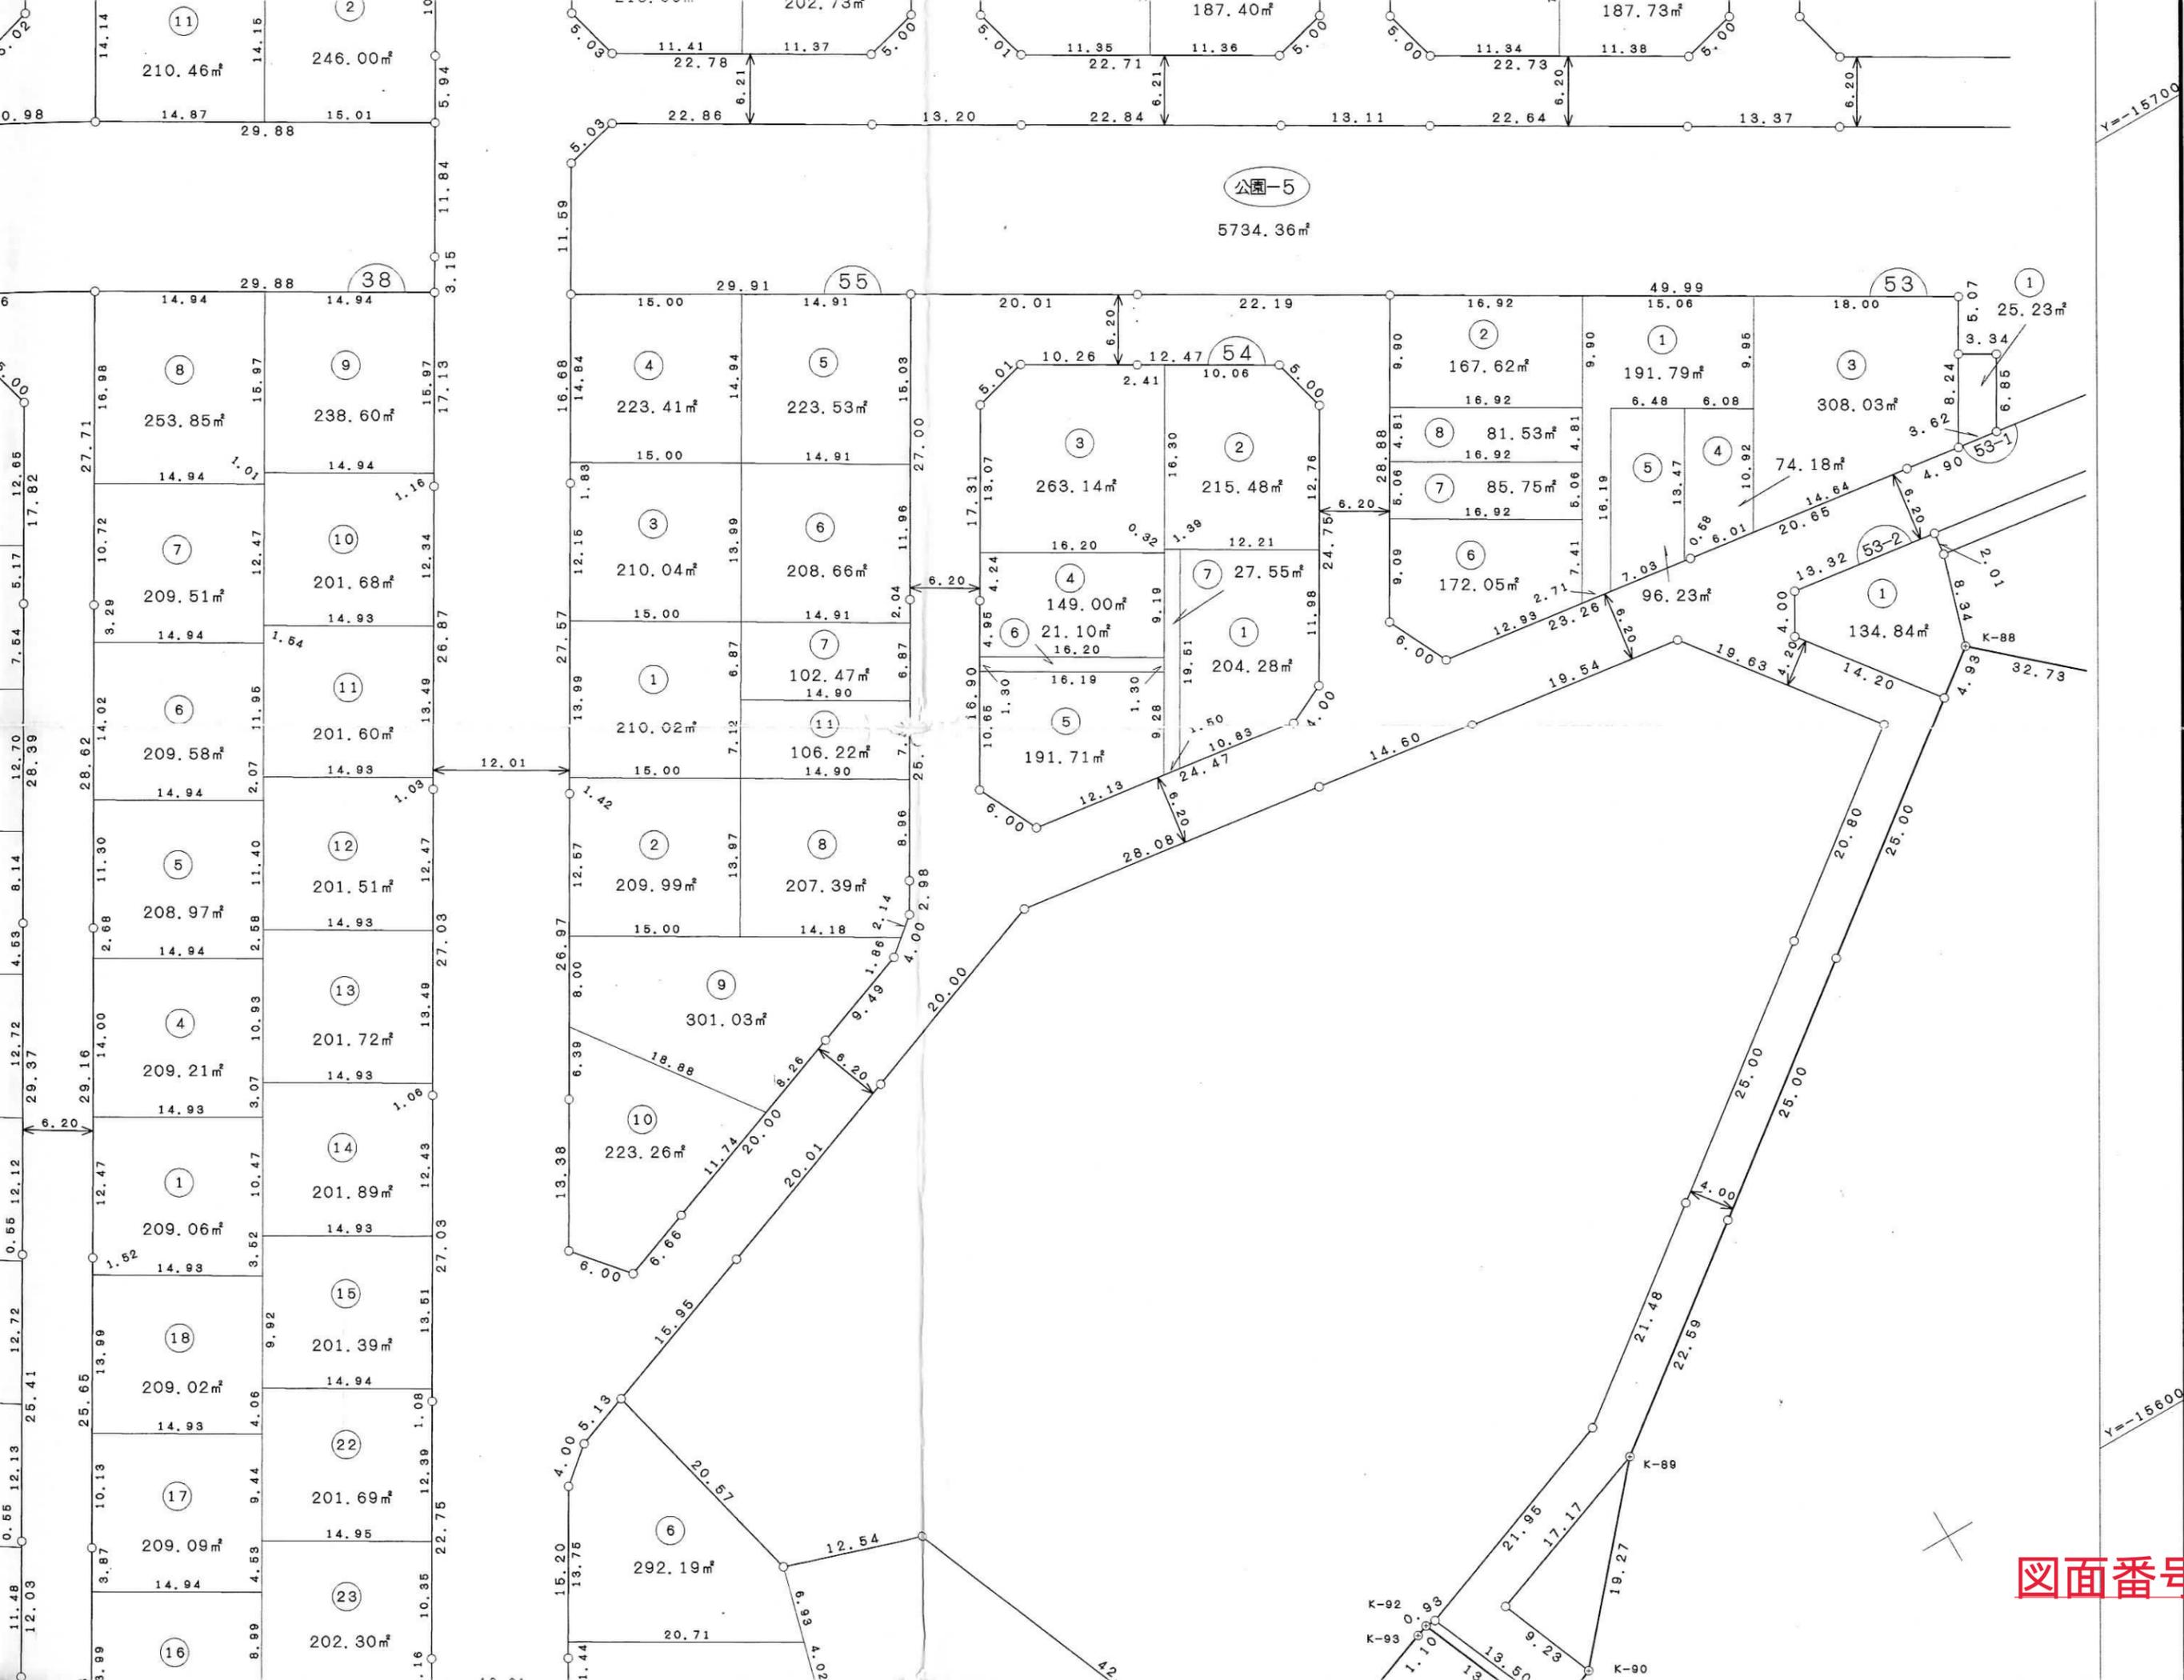

図面番号 : 33



図面番号：34



